


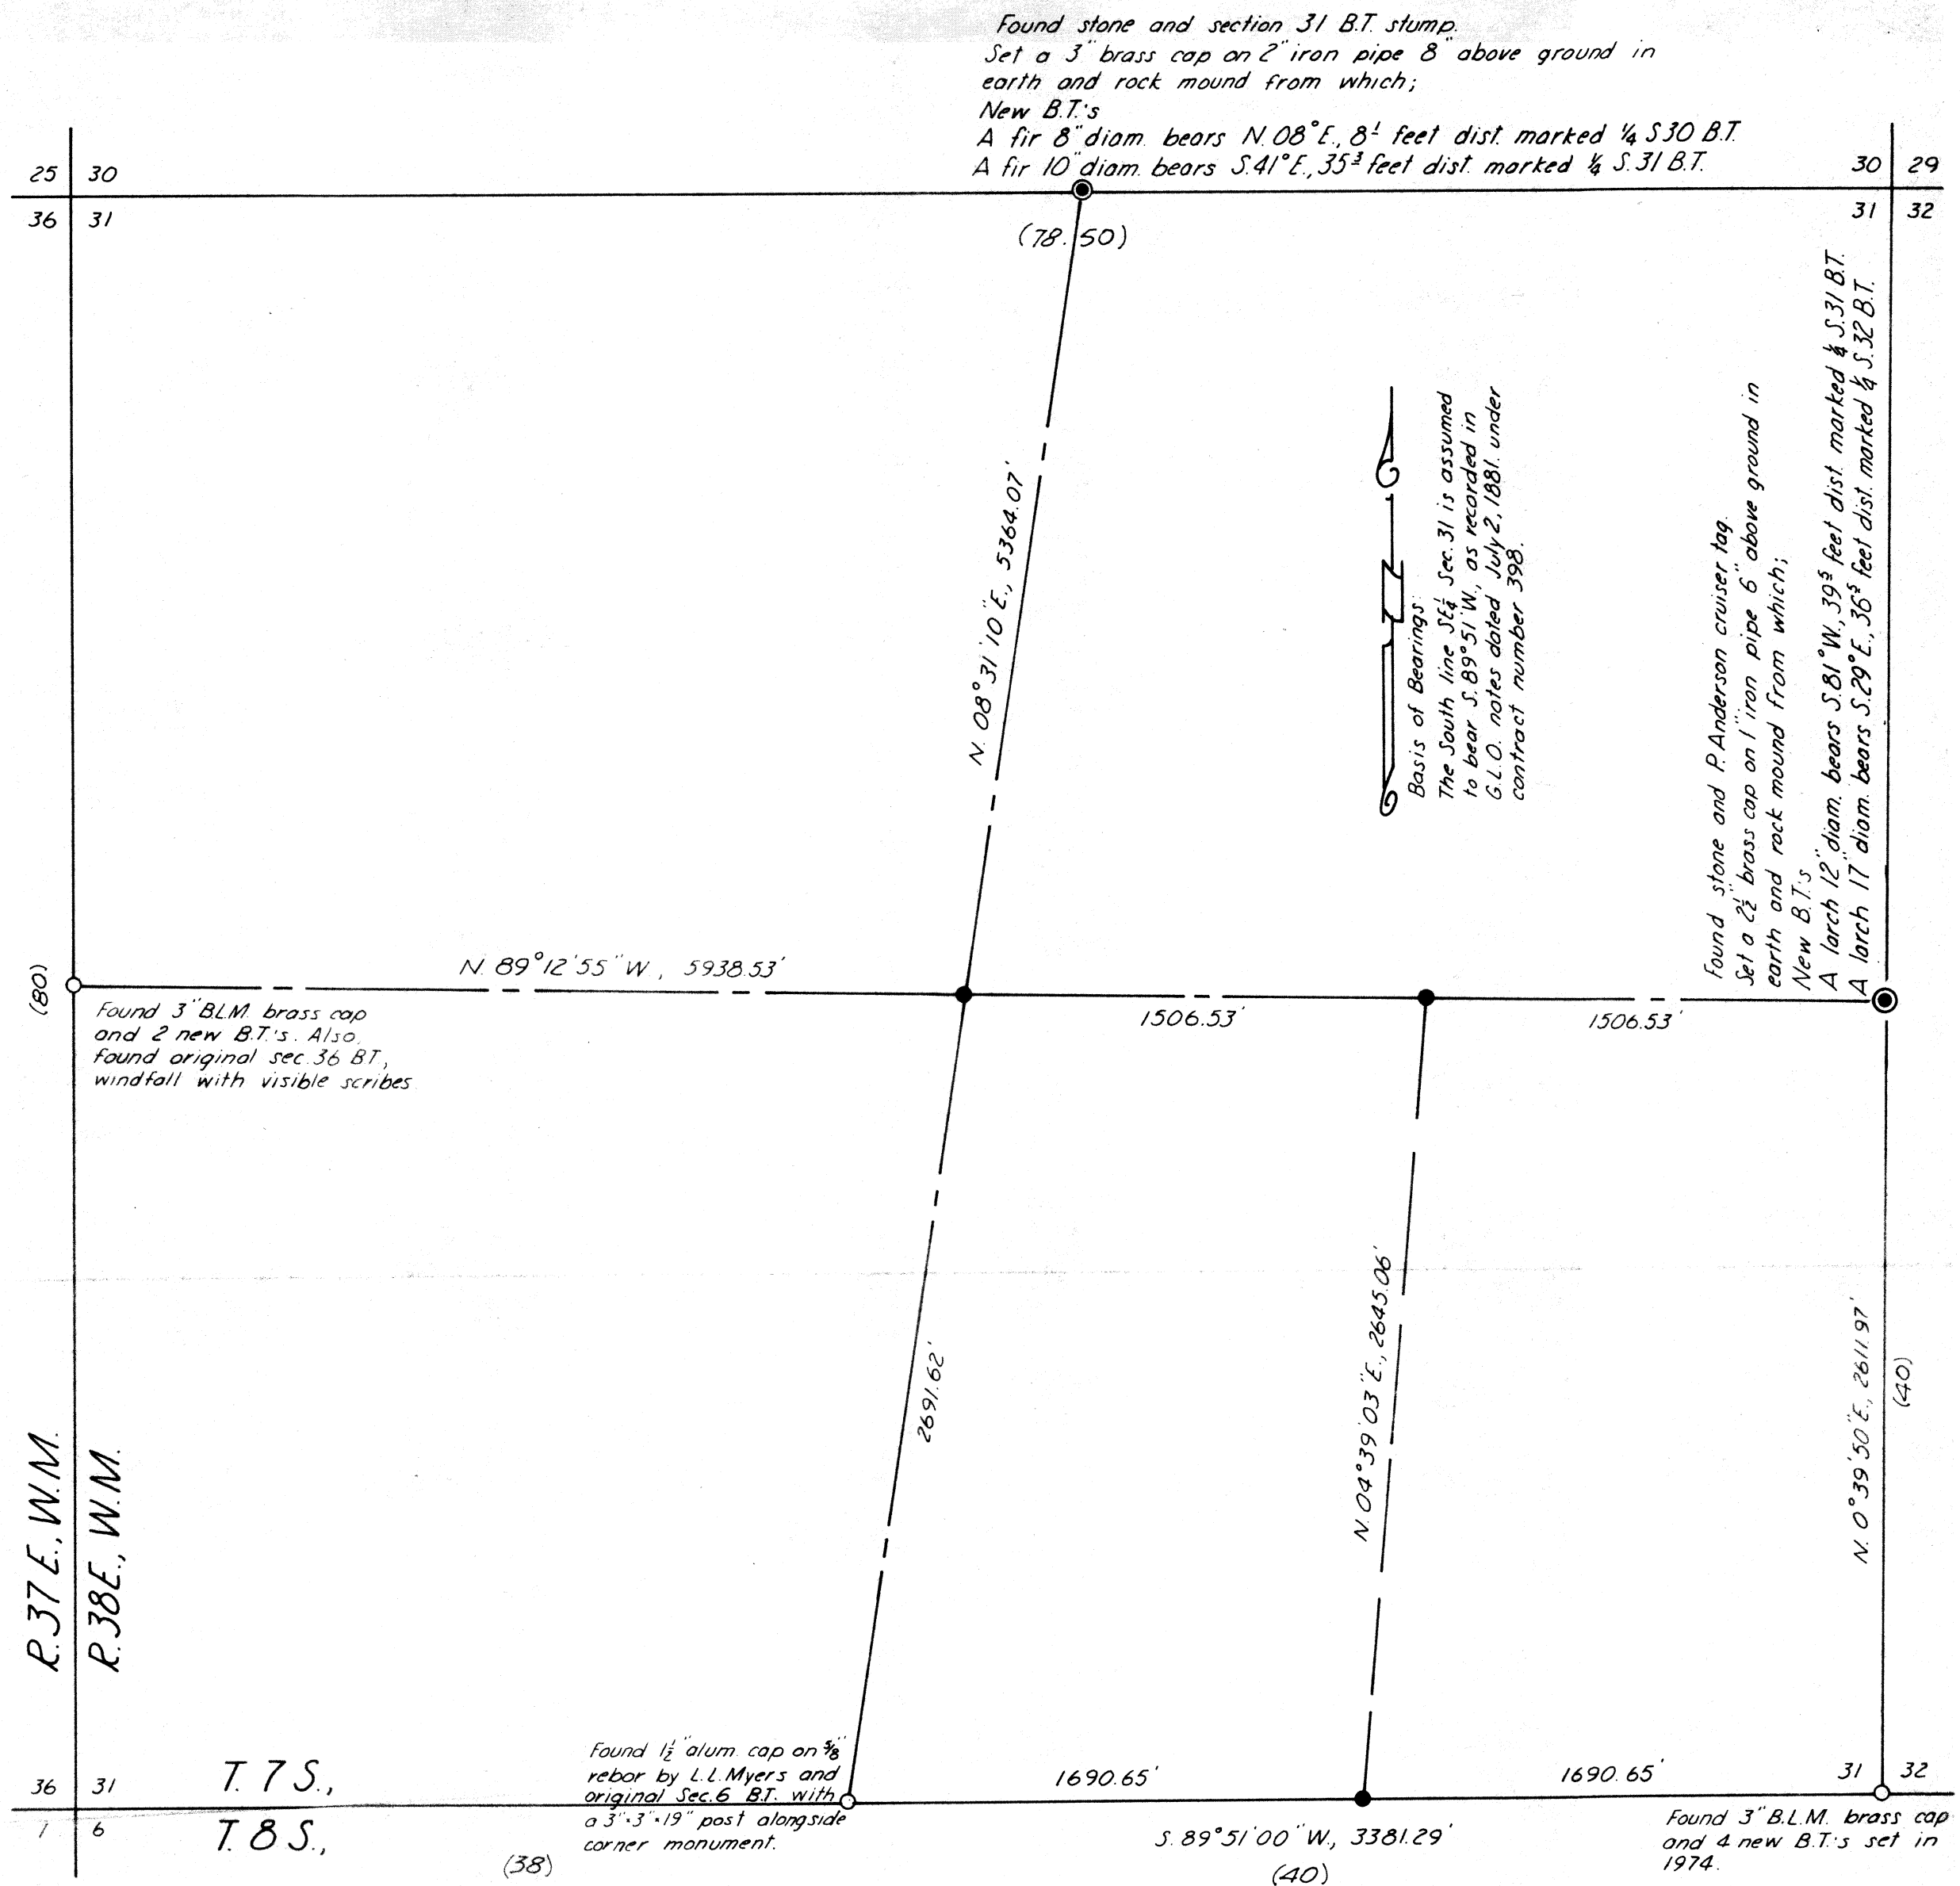

LEGEND

- Indicates found monument as described.
- " set monument as noted.
- " set 2 $\frac{1}{2}$ " alum cap on 1" iron post.

MAP OF SURVEY THE W $\frac{1}{2}$ OF THE SE $\frac{1}{4}$, SECTION 31, T. 7 S., R. 38 E., W.M.

Dec 28, 1976

Surveyed Nov. 17-Dec. 17, 1976

Scale 1"=500'

For Harvey Phillips

7-38-6

