


Meridian by Solar Observation

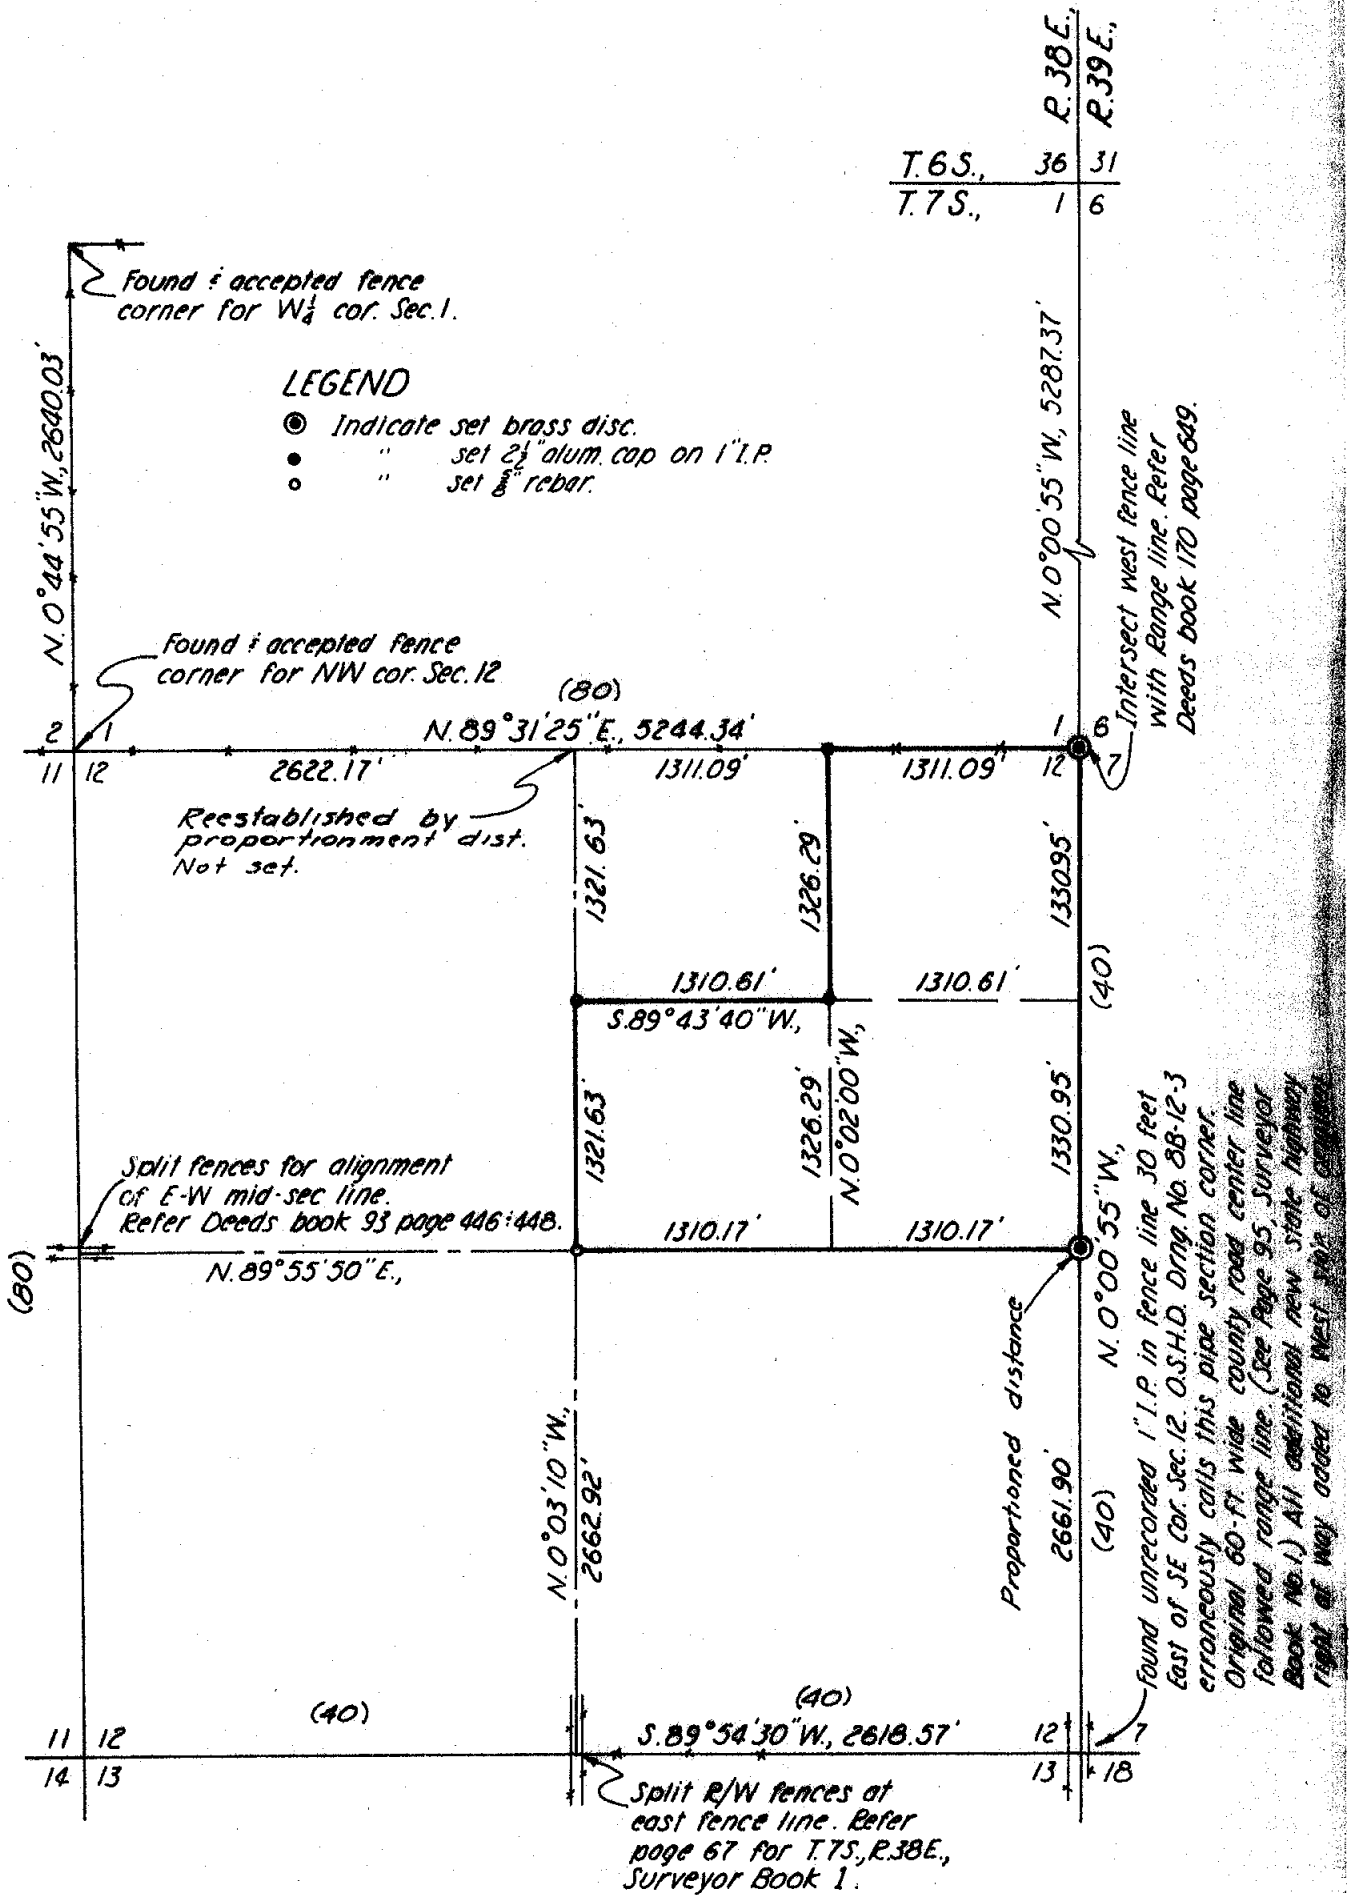

MAP OF SURVEY
A PARCEL IN THE NE 1/4 SEC. 12, T. 7S., R. 38E., W.M.
 Surveyed April 22:25 and Aug. 24:29, 1977
 For Ehrman E. Davis

FILED Aug. 31, 1977
 BAKER COUNTY SURVEYOR
 SURVEY NO. 7-38-8

