


RECORD OF SURVEY **BUD JACOBSON TRACT** **SECTION 28, T7S R38E WM** **BAKER COUNTY OREGON** **Scale 1"=1000' Date 1-30-78**

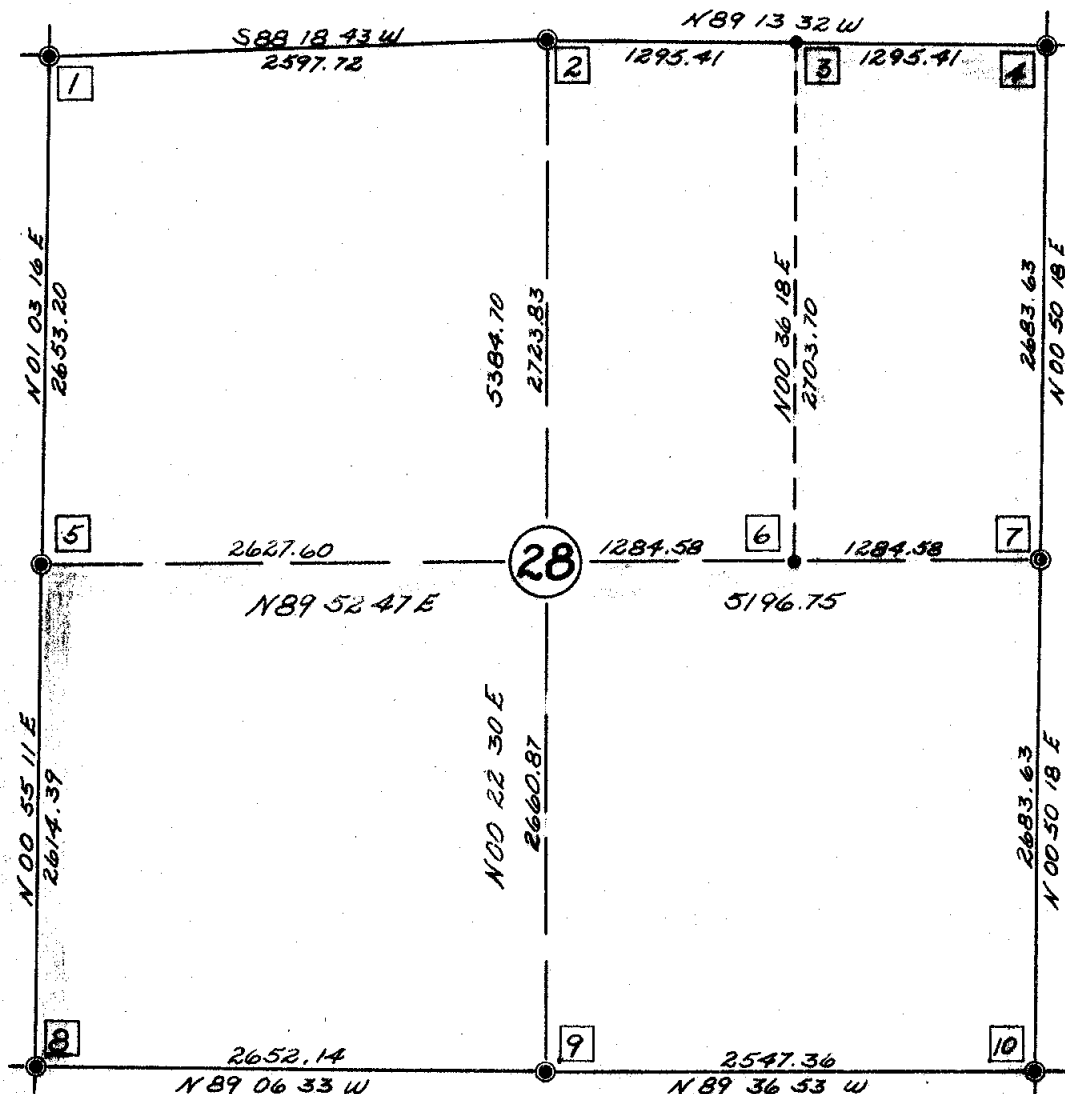

NOTE: True meridian determined by a Solar Observation.

LEGEND:

- Sec. or 1/4 cor. found.
- ⊙ 1/4 cor. set by prop. meas.
- Subdivision cor. set.
- () GLO call bear & dist.

- 1 20/21 29/28 Found part of a scribed post and bearing tree stumps, as per GLO notes.
- 2 1/4 21/28 Found one bearing tree, restored 1/4 cor. to its original position.
- 3 E 1/10 21/28 Set iron pin in mound of stone.
- 4 21/22 28/27 Determined old fence intersection to be actual/sec cor as per GLO notes.
- 5 1/4 29/28 Found one bearing tree stump, restored 1/4 cor. to its original position. New bearing trees: Larch 14" dia. bears N12E, 12.3 ft 1/4 S BT Lodge Pole 8" dia. bears N54W, 31.0 ft 1/4 S BT Set an iron pin in a mound of stone.
- 6 E-C 1/16 sec 28 set iron pin in mound stone.
- 7 1/4 28/27 Made extensive search, found no trace of cor. a area burned in early 1900's. Set iron pin in mound of stone by proportionate measurements.
- 8 29/28 32/33 Found an iron pipe at corner location and bearing trees as described in the GLO notes.
- 9 1/4 28/33 Found a stone 16x10x8 and rotted bearing trees fitting the GLO notes.
- 10 28/27 33/34 Found no evidence of original corner used an existing fence intersection as the corner location.

CERTIFICATE OF SURVEY:

I, James H. Hambleton, being a registered Land Surveyor in the State of Oregon, do hereby certify that this plat correctly represents a survey made by me or under my direction, for Bud Jacobson, using public and private records and in conformance with the BLM manual and the laws of the State of Oregon.

James H. Hambleton
OALS #645

FILED Feb. 6, 1978

BAKER COUNTY SURVEYOR

SURVEY NO. 7-38-9

REGISTERED
PROFESSIONAL
LAND SURVEYOR

James H. Hambleton

OREGON
JULY 10, 1964
JAMES H. HAMBLETON
645