


**LEGEND**

- FOUND 5/8" REBAR
- SET 5/8" REBAR WITH ORANGE CAP

BASIS OF BEARING:  
SECTION LINE BEING  
N 89° 18' 30"E.

REFERENCE: SURVEY  
7-38-2

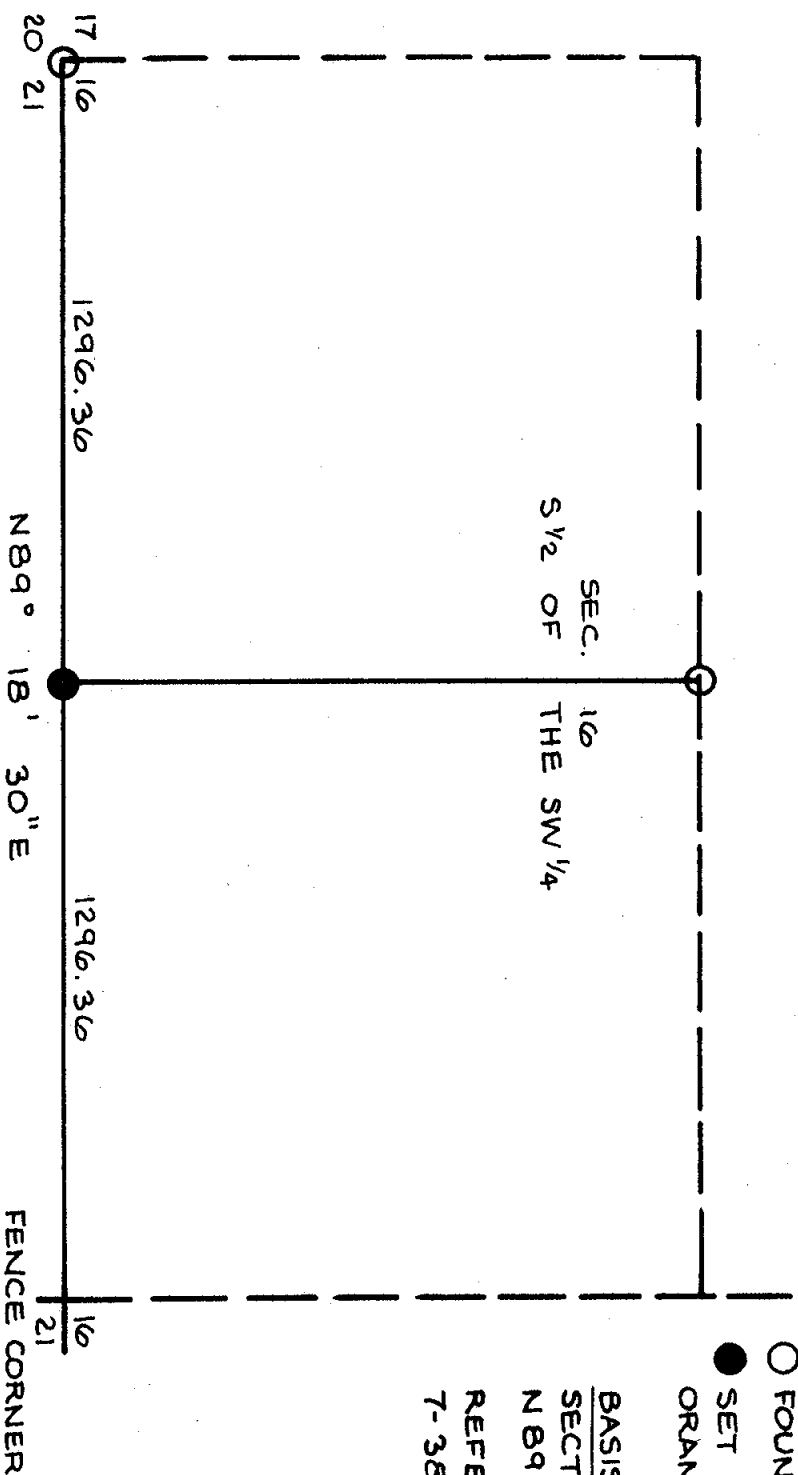

REGISTERED  
PROFESSIONAL  
LAND SURVEYOR

*Barry B. Barbour*

OREGON  
OCT. 17, 1975  
BARRY B. BARBOUR  
1051

FILED *May 8, 1978*

BAKER COUNTY SURVEYOR

SURVEY NO. 7-38-11

SINGLE PROPORTIONATE SURVEY OF THE WEST  
HALF OF SECTIONS 16 & 21, SECTION LINE,  
T7S, R38E, W.M., BAKER COUNTY, OREGON

FOR KENNETH BOYER, HAINES, OREGON

SCALE  
1" = 400'

BARRY B. BARBOUR

SHEET NO.

1

DATE

APR. 1978

LAND SURVEYOR

1