

CERTIFIED RECORD OF LAND CORNER MONUMENTATION

History of original corner establishment:

Corner established by William R. Gradon under GLO contract no. 445 dated June 1, 1882.

Surveyor General records state:

Set a post 3 ft long 3 ins square 24 ins in the ground for 1/4 sec cor marked 1/4 S on N face from which;

A pine 20 ins diam bears N 40° W, 96 lks dist marked 1/4 S BT
A tamarack 12 ins diam bears S 85° W, 22 lks dist marked 1/4 S BT

DIAGRAM

T 7 S R 38 E
 $\frac{1}{4}$ $\frac{S 5}{S 8}$


Description of corner evidence found:

Found an 18 inch tamarack with typical bearing tree blaze on East side and used as a fence corner for many years for Section 8 bearing tree.

Found a 24 inch pine stump sawed very low to the ground for Section 5 bearing tree.

This position is at a point on the line between Sections 5 and 8 which is 580 feet (8.8 chains as in the GLO record) East of North Powder River.

NOTE: These two record accessory bearing trees were recovered by me in September, 1957, at which time the Section 5 bearing tree was standing with the typical bearing tree blaze on southeast face.

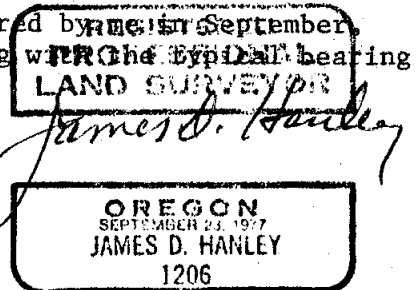


Description of monument and accessories I established to perpetuate the original location of this corner:

Set a 2½ inch brass cap on a 1 inch iron pipe 31 inches long and projecting 6 inches out of the ground with a surrounding mound of earth and stone at the record position established from the found accessory bearing trees.

Brass cap marked thus:

T 7 S R 38 E
 $\frac{1}{4}$ $\frac{S 5}{S 8}$
CS 1981

I hereby certify that the above corner was remonumented properly under my supervision on June 15, 1981, and witnessed by Brad Gordon, Tom Fisk, and Jim DeMastus.

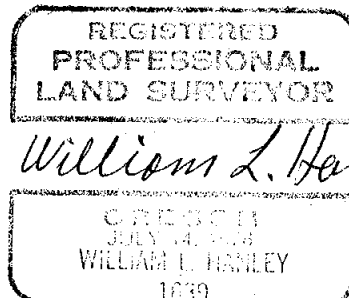

Office of..... County of.....
State of....., I hereby certify that the within instrument was filed in this office
for record on the..... day of....., 19.....
..... by
(COUNTY OFFICIAL) (DEPUTY)

Form R6-7100-57 (9/71)

FILED July 9, 1981

BAKER COUNTY SURVEYOR
SURVEY NO. 7-38-19