


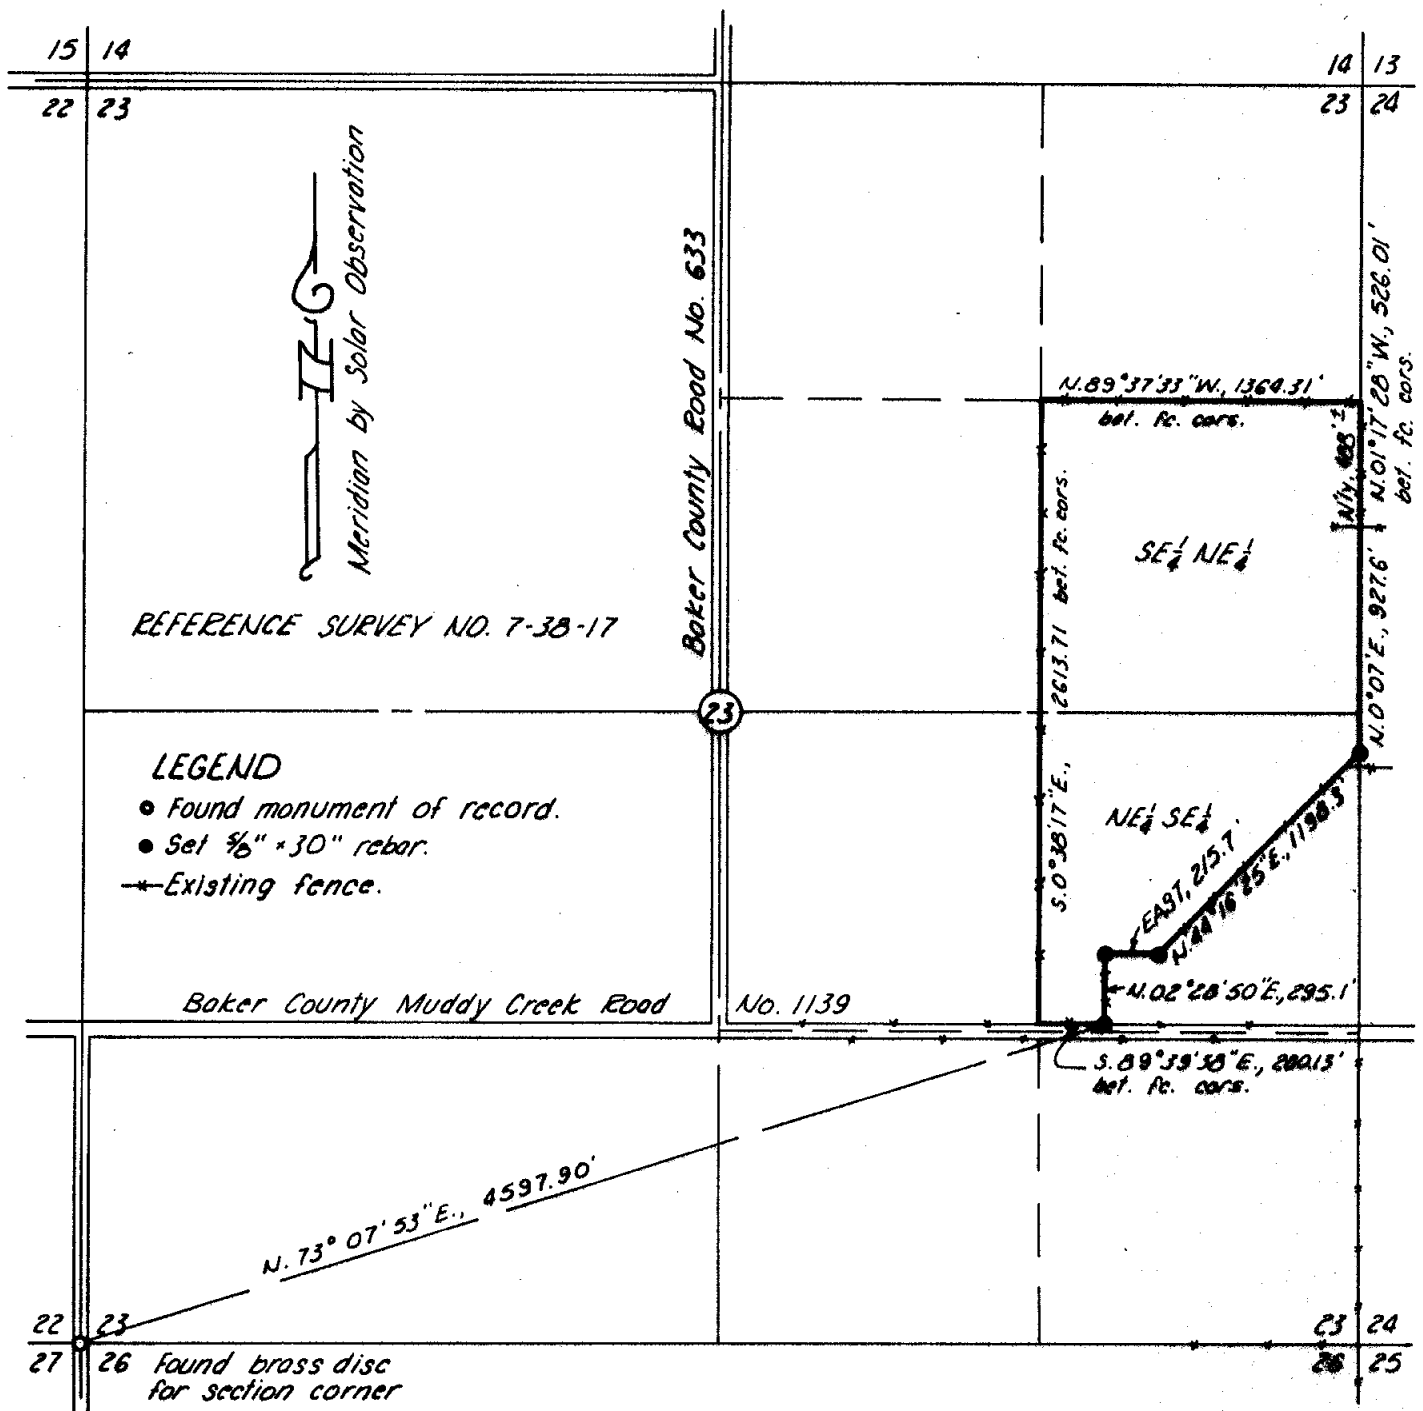

SURVEY NARRATIVE

This survey was performed at the request of Bill Loennig for the purpose of description preparation and partial boundary monumentation to alienate this parcel from a single larger parcel owned by Mr. Loennig.

REGISTERED
PROFESSIONAL
LAND SURVEYOR

James D. Hanley
OREGON
SEPTEMBER 23, 1977
JAMES D. HANLEY
1206

MAP OF SURVEY IN THE SE $\frac{1}{4}$ NE $\frac{1}{4}$ & NE $\frac{1}{4}$ SE $\frac{1}{4}$, SECTION 23, T. 7 S., R. 38 E., W.M.

Surveyed Nov. 12 - Dec. 10, 1980

Scale 1"=800'

FOR BILL LEONNIG

FILED Dec. 15, 1980

BAKER COUNTY SURVEYOR

SURVEY NO. 7-38-21