


CERTIFIED RECORD OF LAND CORNER MONUMENTATION

History of original corner establishment:

None. Section was surveyed by Eugene McCormack under GLO Contract No. 398, dated July 2, 1984.

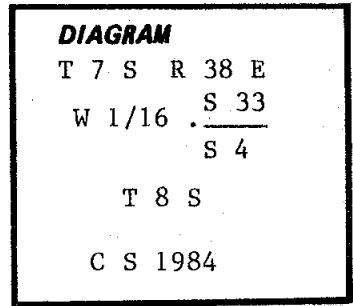

Description of corner evidence found:


None.

Description of monument and accessories I established to perpetuate the original location of this corner:

Set a 2½-inch brass cap on a 1 inch iron pipe 31 inches long and projecting 4 inches out of the ground.

Brass cap is marked as shown on diagram above.

I hereby certify the above corner monument was established as herein described on July 9, 1984, witnessed by Tom Fisk, Larry McBroom and Chris Mahoney.

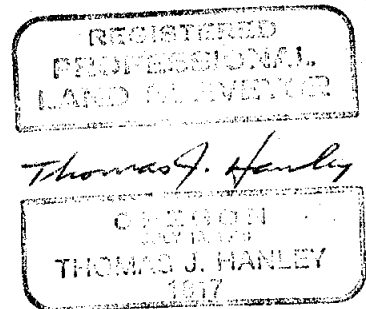

Office of.....County Surveyor..... County of.....Baker.....
State of.....Oregon....., I hereby certify that the within instrument was filed in this office
for record on the...14... day of.....September....., 19..84
..... by
(COUNTY OFFICIAL) (DEPUTY)

Form R6-7100-57 (9/71)

FILED Sept. 14, 1984
BAKER COUNTY SURVEYOR
SURVEY NO. 7-38-25