



ROCK-POWDER CADASTRAL SURVEY

MAGNETIC D EAST

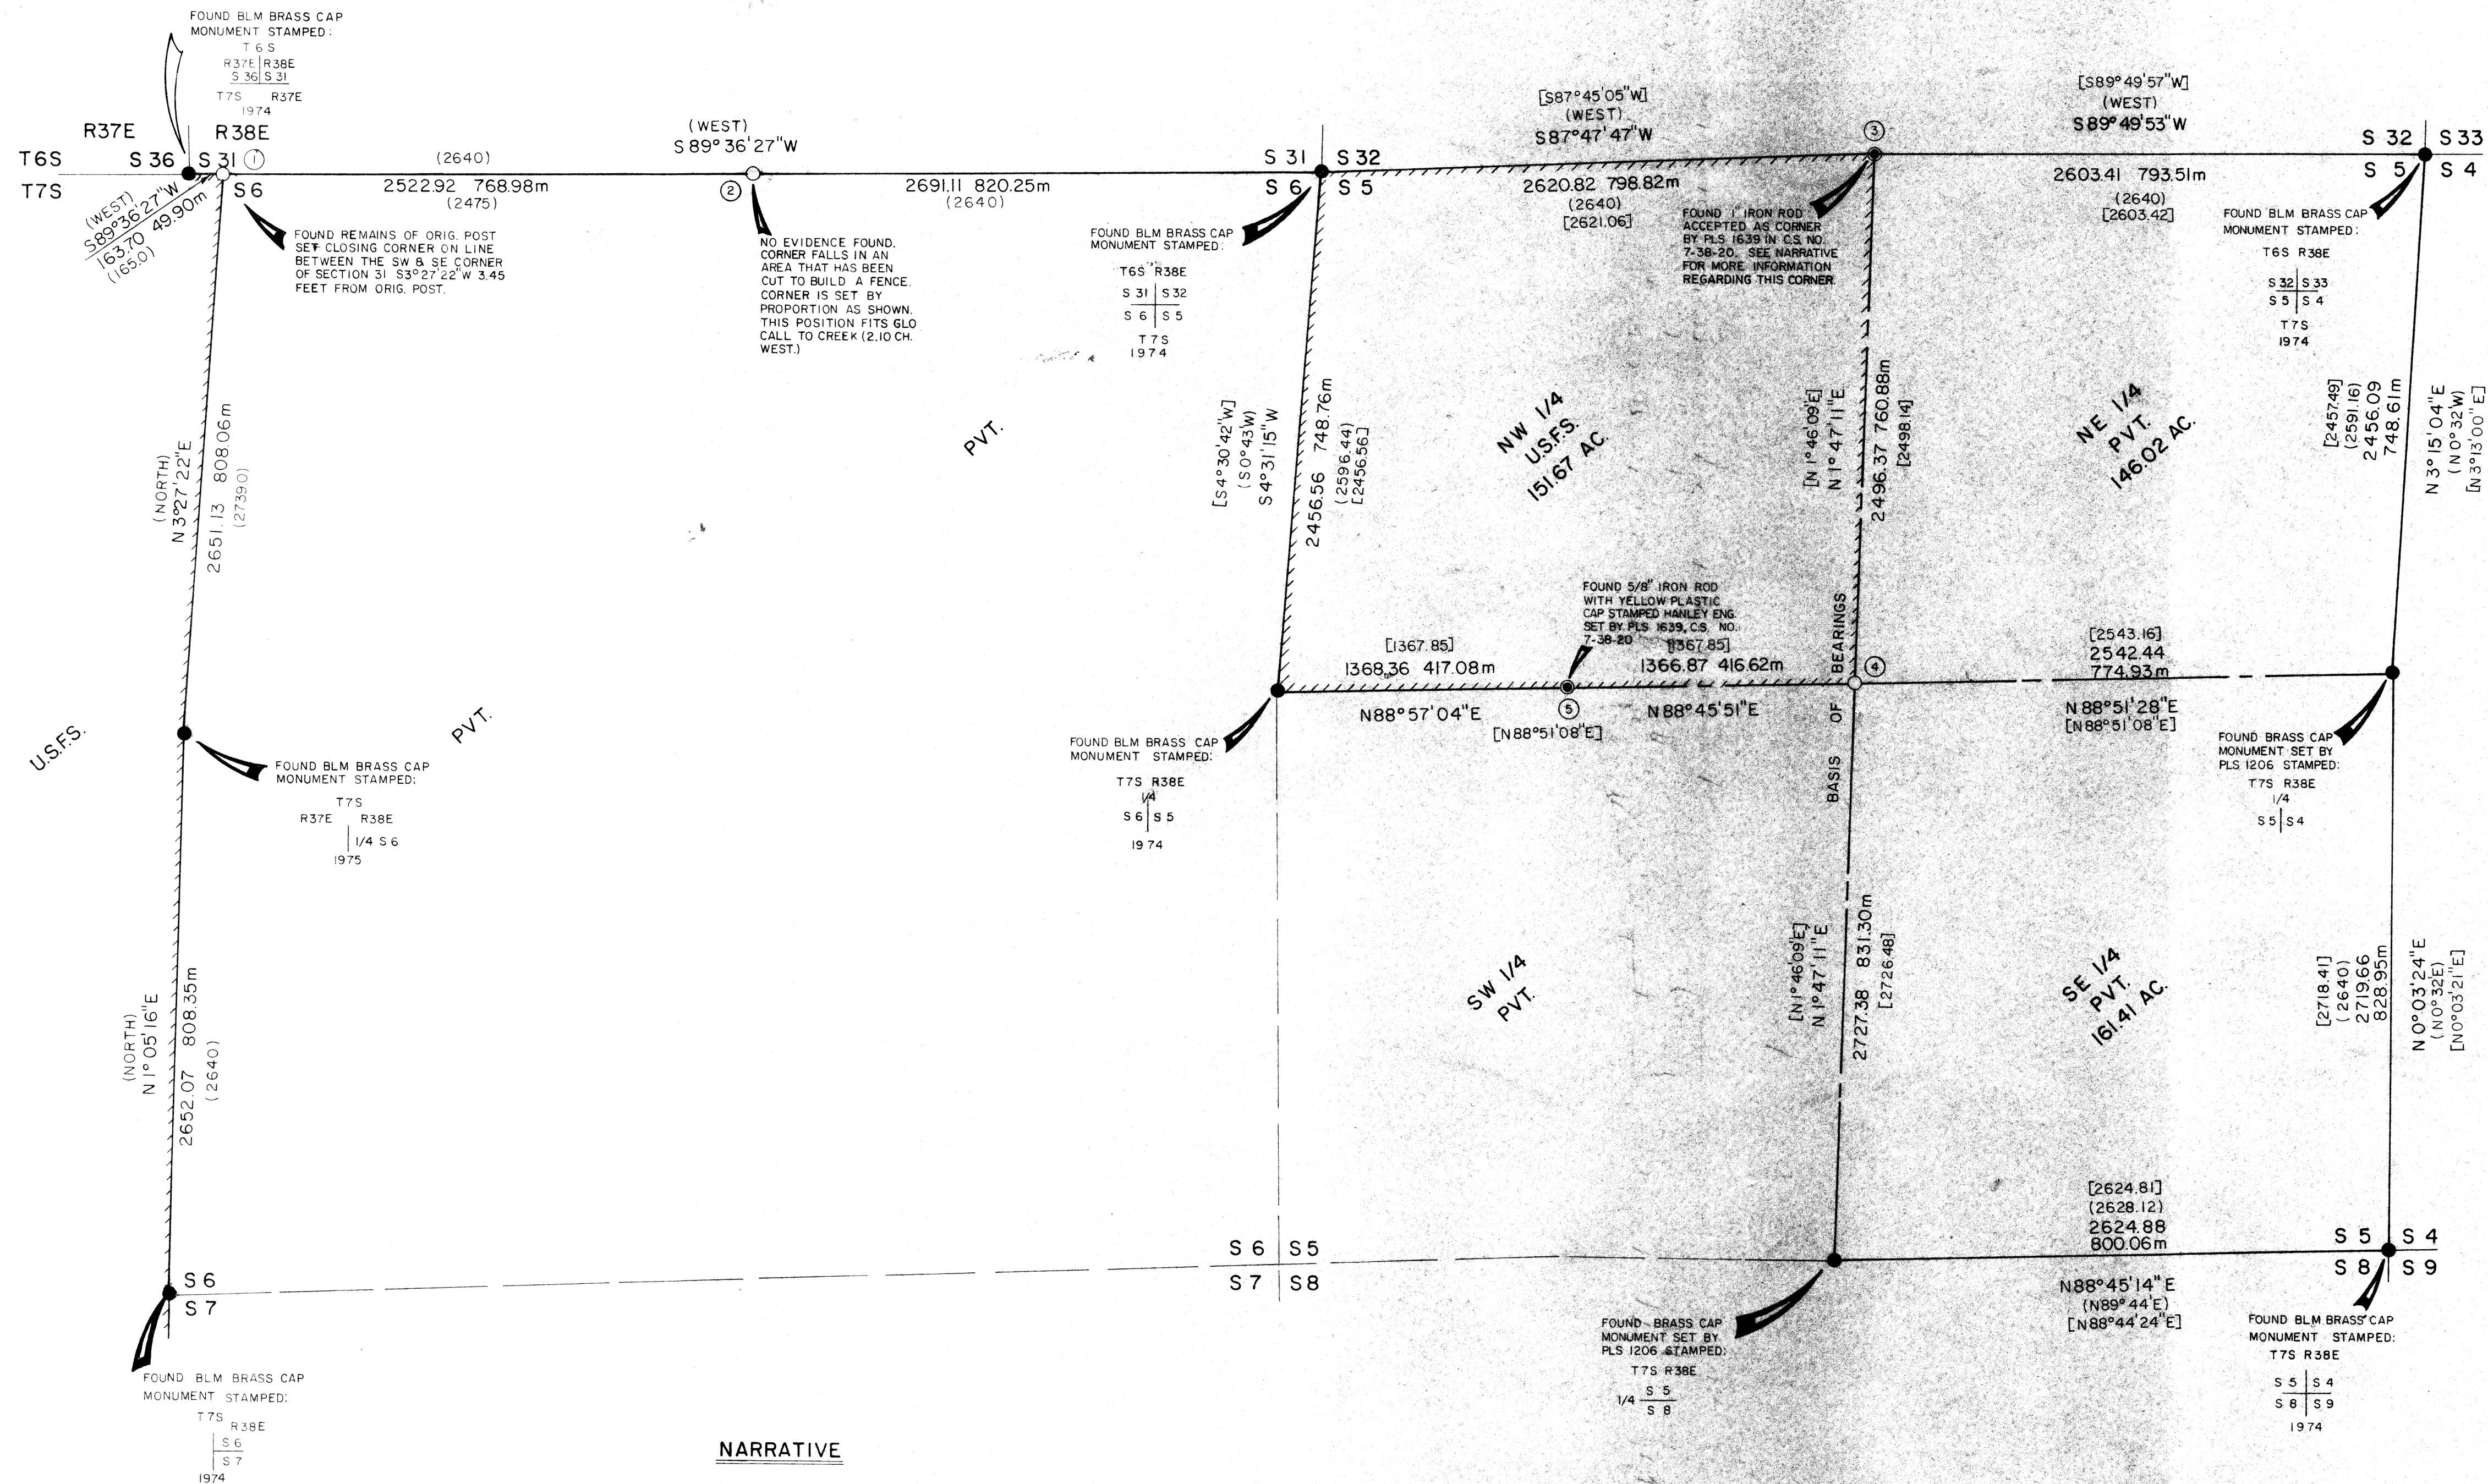

BASIS BEARINGS
SOLAR OBSERVATION WITH TRUE MERIDIAN ALONG THE NORTH-SOUTH CENTER SECTION 5.

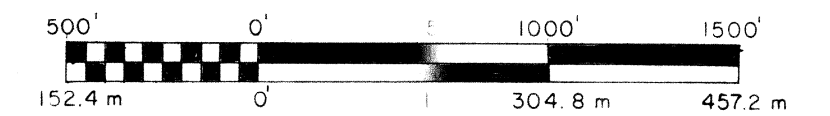

LEGEND

- SET 30"x2-1/2" ALU PIPE WITH 2-1/2" ALUMINUM CAP
- FOUND BRASS CAP MINT. OF RECORD
- FOUND IRON ROD MONUMENTED WITH 30"x2-1/2" ALUMINUM PIPE WITH ALUMINUM CAP
- () RECORD BEARING ORICE FROM ORIGINAL G.L.O. SURVEY
- [] RECORD BEARING ORICE FROM COUNTY SURVEY 7-38-20
- ===== PROPERTY LINE MARK SETTING STEEL POSTS WITH BOUNDARY SIGNS AT 100' INTERVALS OF 400 FEET

MONUMENT

SEE CORRESPONDING NUMBER IN CIRCLE ON P. NAILED BEARING TREE SIGNS, WARNING SIGNS AND BRASS WASHERS STAMPED PLS OR PLS 848 TO EACH TREE. SET STEEL POSTS WITH WARNING SIGNS WITHIN 5' OF CORNER. SEE CERTIFIED RECORD OF LAND CORNER MONUMENTATION AS ON FILE IN TRICE OF THE BAKER COUNTY SURVEYOR FOR COMPLETE DESCRIPTION OF HISTORY, MON. SET AND ACCESSORIES ESTABLISHED. (ALUMINUM CAPS STAMPED AS SHOWN)

- | | |
|---|--|
| <p>① T6S R38E
S31 CC
T7S R38E
1984
PLS 2065</p> | <p>A PINE 6" DIA. BEARS N 45° FT. SCRIBED, T6S R38E S31 CC BT
A TAMARACK 8" DIA. BEARS E 19.4° FT. SCRIBED T7S R38E S6 CC BT</p> |
| <p>② T6S R38E
1/4 S6
T7S
1984
PLS 2065</p> | <p>A FIR 40" DIA. BEARS S 23° FT. SCRIBED, 1/4 S6 BT
A SPRUCE 7" DIA. BEARS N 17° FT. SCRIBED, 1/4 S31 BT</p> |
| <p>③ T6S R38E
1/4 S32
S5
T7S
1984
PLS 2065</p> | <p>A PINE 18" DIA. BEARS N 13° FT. SCRIBED, 1/4 S32 BT
A " " " " S 17° FT. SCRIBED, 1/4 S5 BT</p> |
| <p>④ T7S R38E
C 1/4
S5
1984
PLS 2065</p> | <p>A PINE 20" DIA. BEARS 17° FT. SCRIBED, C 1/4 S5 BT
A " " " " 14" " " " 12° FT. SCRIBED, C 1/4 S5 BT</p> |
| <p>⑤ T7S R38E
W 1/6
C S5
RM 400
1984
PLS 2065</p> | <p>A PINE 16" DIA. BEARS N 46.5° FT. SCRIBED, CW 1/6 S5 BT
A " " " " 8" " " " S 78.6° FT. SCRIBED, CW 1/6 S5 BT</p> |

NARRATIVE

THIS SURVEY IS PERFORMED AT THE REQUEST OF THE WALLOWA WHITMAN NATIONAL FOREST, THE PURPOSE OF WHICH IS THE SUBDIVISION OF SECTION 5, SUBSEQUENT TO THE MONUMENTATION AND POSTING OF THE FOREST BOUNDARY AS SHOWN ABOVE ON THE MAP. ALL RETRACEMENT, RESTORATION, SUBDIVISION AND MONUMENTATION IS CARRIED OUT IN CONFORMANCE WITH THE PERTINENT PROVISIONS OF THE 1973 ADDITION OF THE "BUREAU OF LAND MANAGEMENT, MANUAL OF SURVEYING INSTRUCTIONS".

POSITIONAL CONTROL IS PROVIDED BY A CLOSED TRAVERSE NETWORK. ELECTRONIC DISTANCE MEASURING EQUIPMENT, THEODOLITE AND HP-86B COMPUTER ARE USED TO OBTAIN THE MEASUREMENTS AND PERFORM THE COMPUTATIONS. FIELD NOTES AND COMPUTATIONS ARE ON FILE IN THE OFFICE OF FERGUSON SURVEYING AND ENGINEERING MT. VERNON, OREGON.

AT THE NORTH 1/4 CORNER OF SECTION 5 I FOUND A 1" IRON ROD. THIS ROD WAS FOUND 35 YEARS AGO BY JAMES HANLEY, THE BAKER COUNTY SURVEYOR, AND ACCEPTED IT AS A PERPETUATION OF THE ORIGINAL CORNER. COUNTY SURVEY NO. 7-38-20 BY BILL HANLEY SHOWS SAID ROD TO FIT SURROUNDING EVIDENCE. JAMES AND BILL HANLEY BOTH STATE THAT OTHER UNRECORDED PERPETUATIONS EXIST IN THIS AREA THEREFORE THE ROD IS ACCEPTED AS THE BEST AVAILABLE EVIDENCE OF THE CORNER POSITION.

I, J. DAVID BRINTON, REGISTERED PROFESSIONAL LAND SURVEYOR IN THE STATE OF OREGON, HEREBY CERTIFY THAT THIS PLAT AND THE NOTES HEREON ARE A CORRECT REPRESENTATION OF THE SURVEY I PERFORMED DURING SEPT, 1984 FOR THE U.S. FOREST SERVICE IN ACCORDANCE WITH THE STATUTES OF THE STATE OF OREGON AND WITH THE ARTICLES OF MY CONTRACT, CONTRACT NO. 53-04M3-4-3010.

J. DAVID BRINTON OR. PLS 2065

HISTORY

IN 1881, E.P. MCCORNACK ESTABLISHED THE WEST LINE OF T.7S, R.38E. UNDER G.L.O. CONTRACT NO. 398.

IN 1881, W.B. BARR ESTABLISHED THE NORTH LINE OF SECTIONS 5 AND 6, T.7S, R.38E. UNDER G.L.O. CONTRACT NO. 388.

IN 1882, W.R. GRADON SUBDIVIDED T.7S, R.38E. UNDER G.L.O. CONTRACT NO. 445.

IN 1981, SECTION 5 WAS SUBDIVIDED BY W.L. HANLEY (C.S. NO. 7-38-20) AND CORNERS WERE REMONUMENTED AS SHOWN ABOVE.

IN THE COURSE OF THIS SURVEY CORNERS MONUMENTED BY THE B.L.M. AND C.S. 7-38-20 ARE MAINTAINED BY SCRIBING NEW BEARING TREES, INSTALLING STEEL POSTS WITH APPROPRIATE SIGNS, NAILING APPROPRIATE SIGNS TO BEARING TREES AND PAINTING 6" RED BANDS AROUND BEARING TREES AS NEEDED TO BRING THE MONUMENTATION TO U.S.F.S. STANDARD.

FILED JAN 11 1985
BAKER COUNTY SURVEYOR
SURVEY NO. 7-38-26

J. DAVID BRINTON
BAKER COUNTY SURVEYOR

BRINTON SURVEYING

MT. VERNON, OREGON

MAP OF SURVEY

SUBDIVISION OF SECTION 5, T.7S, R.38E, W.M. AND THE NORTH LINE OF SECTION 6, T.7S, R.38E, W.M.

BAKER COUNTY, OREGON

DR. WALLOWA WHITMAN NATIONAL FOREST BY J. DAVID BRINTON

DATE: SEPT., 1984 DRAWN BY: D. BRINTON SCALE: 1" = 500'