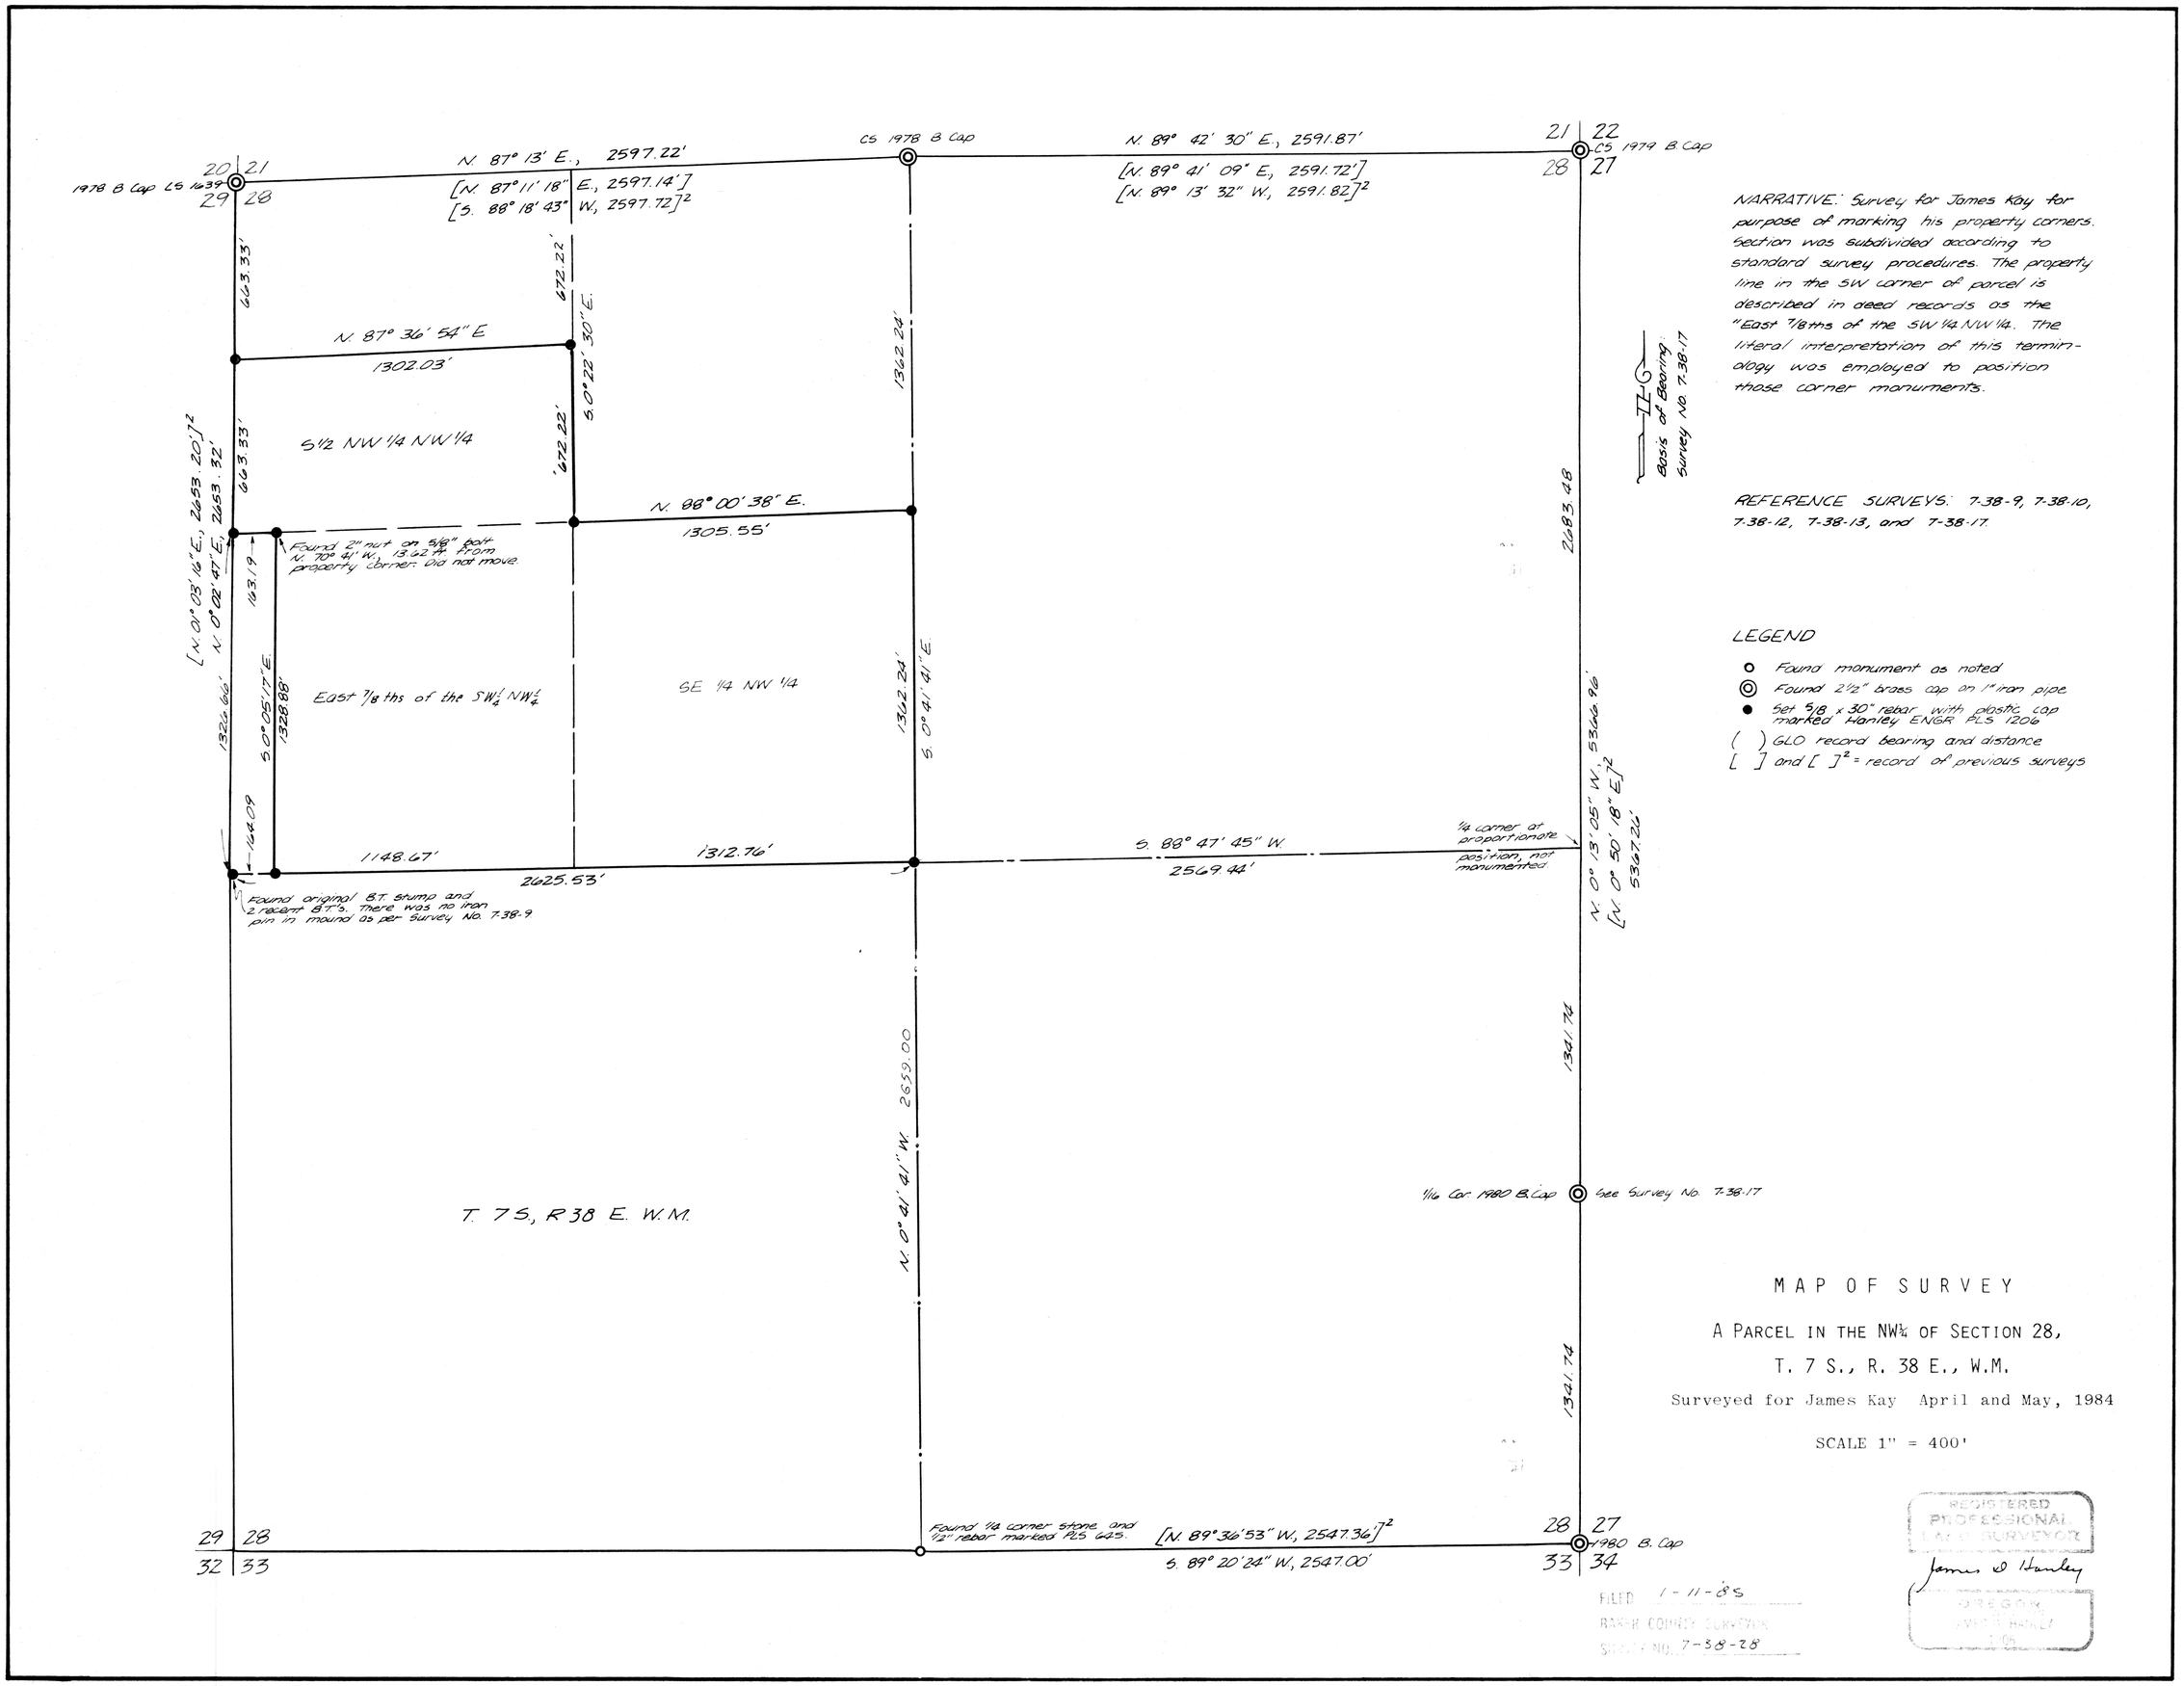

NARRATIVE: Survey for James Kay for purpose of marking his property corners. Section was subdivided according to standard survey procedures. The property line in the SW corner of parcel is described in deed records as the "East 7/8ths of the SW 1/4 NW 1/4. The literal interpretation of this terminology was employed to position those corner monuments.

REFERENCE SURVEYS: 7-38-9, 7-38-10, 7-38-12, 7-38-13, and 7-38-17.

LEGEND

- ○ Found monument as noted
- ◎ Found 2½" brass cap on 1" iron pipe
- ● Set 5/8 x 30" rebar with plastic cap marked Hanley ENGR PLS 1206
- ( ) GLO record bearing and distance
- [ ] and [ ]² = record of previous surveys

MAP OF SURVEY

A PARCEL IN THE NW¼ OF SECTION 28,

T. 7 S., R. 38 E., W.M.

Surveyed for James Kay April and May, 1984

SCALE 1" = 400'

REGISTERED PROFESSIONAL LAND SURVEYOR

James O Hanley

OREGON JAMES HANLEY 1206

FILED 1-11-85

BAKER COUNTY SURVEYOR

SURVEY NO. 7-38-28