


History of original corner establishment:

Corner originally established in 1882, by William R. Braden, under "General Land Office Contract" No. 445, Surveyor General's Notes States:
Set post 3 ft. long 3 ins. sq., 24 ins. in the ground, for 1/4 sec. cor., marked 1/4 S on N face, from which:

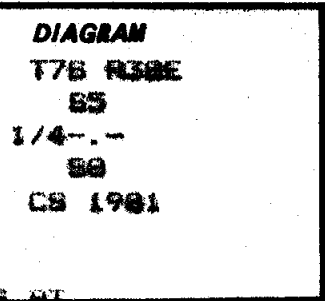

A Pine 20 ins dia. bears N40W, 96 lks dist. mkd. 1/4 S BT
A tamarack 12 ins. dia. bears S84W, 22 lks dist. mkd. 1/4 S BT
In 1981 James D. Hanley PLS 1206 & William L. Hanley, PLS 1639, remonumented this corner at record distance from original bearing trees, whereby they set a 1" iron pipe with 2-1/2" brass cap stamped as shown on the DIAGRAM, set with 6" above the ground and surrounding mound of earth and stone.
(No bearing trees established by Hanley monumentation)

Description of corner evidence found:

Found 1" iron pipe with 2-1/2" brass cap stamped as shown on the DIAGRAM, set in a small mound of stone & earth.

Found original bearing trees as established in 1882.
A tamarack 18" dia. live in good condition, with blaze healed over, in fence corner, bears S85W., 22 lks.
A 24" Pine stump, cut low to the ground, bears N40W, 96 lks.
(In 1957 James D. Hanley found the Section 5 Bearing Tree standing, with blaze healed over.)

Description of monument and accessories | established to perpetuate the original location of this corner:


Maintained Corner Monument by setting a steel post with warning sign North 2 ft. from Corner.

Maintained original bearing trees by painting a 6" red band around and nailing bearing tree and warning signs on each tree.

Scribed New Bearing Trees.

A Fir, 14" dia. bears S15W., 16.4 ft., scribed 1/4 S8 BT
A Fir, 12" dia. bears N35E., 31.2 ft., scribed 1/4 S5 BT

Nailed a brass washer stamped PLS 848, on blaze above BT scribe, Bearing Tree sign above blaze, and warning sign on back of each new tree.
Painted a 6" red band at breast ht. around each new tree.
(Douglas M. Ferguson, PLS 848 scribed new trees)

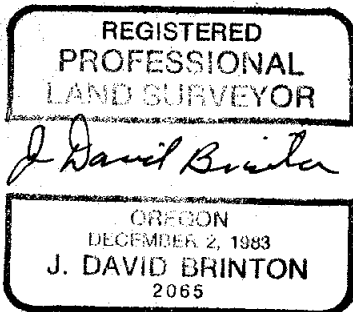

Corner Maintained Sept. 19, 1984
Witnessed by Douglas M. Ferguson, PLS 848

Office of..... County of.....
State of....., I hereby certify that the within instrument was filed in this office
for record on the..... day of....., 19....
..... by
(COUNTY OFFICIAL) (DEPUTY)

FILED 2-15-85
BAKER COUNTY SURVEYOR
SURVEY NO. 7-38-41