


CERTIFIED RECORD OF LAND CORNER MONUMENTATION

INDEX 6-1

History of original corner establishment:

Corner originally established in 1881, by Eugene P. McCormack, under "General Land Office Contract" No. 398, Surveyor Generals Notes State: (Abridged notes) Set Basalt stone 24x14x9 ins. 18 ins. in the ground, from which:
A pine 12" dia. bears N55E 29 lks. and. 1/48 BT
A pine 4" dia. bears N40W 20 lks. " 1/48 BT

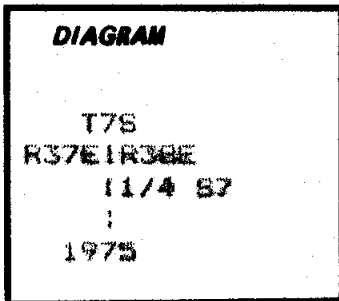

In 1974 the Bureau of Land Management Remonumented this corner. from existing physical evidence. See FIELD NOTES of the "REMONUMENTATION OF CERTAIN ORIGINAL CORNER POINT, TOWNSHIP 7 SOUTH, RANGE 38 EAST," as executed by Lester E. Flecher, Cadastral Surveyor and James J. Carlson, Cadastral Surveyor, under special instructions dated May 3, 1957, approved May 6, 1957, under U.S. Survey Group No. 180

Description of corner evidence found:

Found 3" brass cap monument on 2-1/2" iron pipe, stamped as shown on the DIAGRAM, set with 4" above the ground.

Found original bearing trees, as follow:

A ponderosa pine, 22 ins. diam., bears N64-1/2E., 29 lks. dist., with healed scribe blaze. (Record, N55E), is live in good condition.
A ponderosa pine, snag, 13 ins. diam., bears N40W., 20 lks dist., with scribe marks 1/4 S BT.
Found the bearing tree taken in 1975, A ponderosa pine, 11 ins. diam., dead and standing, bears N55E., 27.12 lks. (Record S68E 26.5 lks.), scribing reads 1/4 S7 BT


Description of monument and accessories | established to perpetuate the original location of this corner:

Corner maintained by setting steel posts with warning and boundary signs, North 4 ft. and South 2 ft. from corner.

Maintained accessories by painting a 6" red band around, and nailing warning signs to back of the original bearing trees.

As scribed original bearing tree, a ponderosa pine 24" dia. bears. N64-1/2E., 19.1 ft., scribed 1/4 S7 BT. nailed brass washer stamped PLS 848 to blaze above BT scribe.

Scribed a new bearing tree, a fir 6" dia. Bears East 18.8 ft. scribed 1/4 S7 BT, planted a 6" red band around tree, nailed a brass washer stamped PLS 848 above BT Scribe and nailed bearing tree and warning sign to tree. Painted a 6" red band around and nailed warning sign to back of tree taken in 1975.

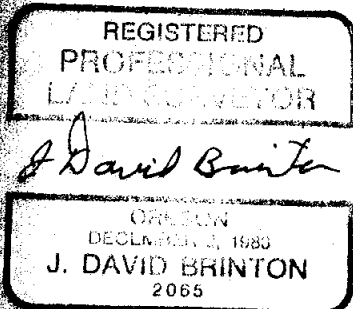

Corner Maintained Sept. 10, 1984
Witnessed by Douglas M. Ferguson. PLS 848
Ferguson also scribed Bearing trees.

Office of..... County of.....
State of....., I hereby certify that the within instrument was filed in this office
for record on the..... day of....., 19.....
..... by
(COUNTY OFFICIAL) (DEPUTY)

Form R6-7100-57 (9/71)

FILED 2-15-85
BAKER COUNTY SURVEYOR
SURVEY NO. 7-38-43

★ GPO—798-276