


History of original corner establishment:

Corner originally established in 1881, by Eugene P. McCornack, under "General Land Office Contract" No. 398, Surveyor Generals Notes State: Set post 3 ft. long, 3 ins square, 24 ins. in the ground for 1/4 Sec. Cor. marked 1/4 S on W face from which

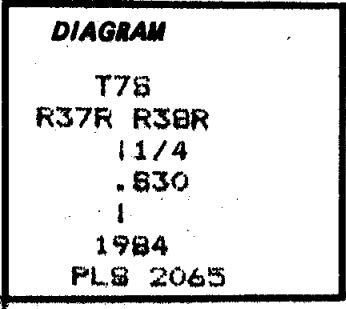

A Fir 8 ins diam bears S55E 11 lks. dist. marked 1/4S BT
A Fir 12 ins diam bears N45W 21 lks dist. marked 1/4S BT

Description of corner evidence found:

No evidence of original post is found, it has completely rotted away.

After revising the search area where it places most of the direction error in the South 1/2 mi. of the west line of sec 30, Found a 16" Fir, live, with what could be a healed blaze face, opened tree and at the proper ring count, is the scribing "1/4". Set a point at record N55W, 7.3 ft from tree. A Fir 30" dia., live, with healed over blaze scar, bears record N45W., 13.9 ft. from said point. Accepted said point, as located from bearing trees as the 1/4 corner position.

Description of monument and accessories established to perpetuate the original location of this corner:

Set 2-1/2" aluminum pipe with 2-1/2" aluminum cap stamped as shown on the DIAGRAM, set 26" in the ground.

From Which

A Fir 12" dia. bears N36E., 10.5 ft. scribed 1/4 S30 BT
A Fir 12" dia. bears S40E., 10.3 ft. " 1/4 S30 BT

Nailed a brass washer stamped PLS 848, on blaze above BT scribe, Bearing Tree Sign above blaze, and warning sign on back of each tree. Painted a 6" red band at breast ht. around each tree. (Douglas M. Ferguson, PLS 848 scribed trees)

Set steel posts with warning and boundary signs North & South 5 ft. from cor.

REGISTERED
PROFESSIONAL
LAND SURVEYOR

J. David Brinton

OREGON
DECEMBER 2, 1983
J. DAVID BRINTON
2065

Corner set Sept. 13, 1984
Witnessed by Douglas M. Ferguson, PLS 848

Office of..... County of.....
State of..... I hereby certify that the within instrument was filed in this office
for record on the..... day of....., 19.....
..... by
(COUNTY OFFICIAL) (DEPUTY)

FILED 2-15-85
BAKER COUNTY SURVEYOR
SURVEY NO. 7-38-50