


CERTIFIED RECORD OF LAND CORNER MONUMENTATION

INDEX 7-2

History of original corner establishment:

In 1978 the Bureau of Land Management Performed
 A Dependent Resurvey of A Portion of the South
 Boundary of T7S, R38E, under special instructions,
 dated March 13, 1978, approved March 28, 1978.
 The Notes from that survey, as executed by
 Dale T. Bedell, cadastral surveyor, states:
 At point for the W 1/16 sec. cor. of sec. 31 only.
 Set an iron post, 28 ins. long, 2-1/2 ins. diam.,
 22 ins. in the ground, with brass cap mkd. (see DIAGRAM)
 from which
 A fir, 10 ins. diam., bears N.40E., 29-1/2 lks. dist., mkd. W1/16 S31 BT
 A Pine, 9 ins. diam., bears N.55W., 50 lks. dist., mkd. W1/16 S31 BT

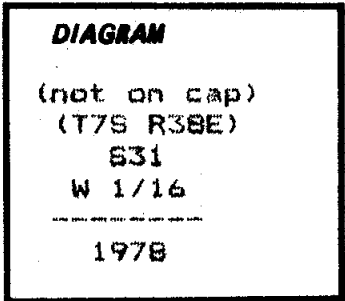

Description of corner evidence found:

Found 3" brass cap monument on 2-1/2" iron pipe stamped as shown on
 the DIAGRAM, set with 6" above the ground.

Found a fir, 10" dia., live in good condition, bears N40E., 19.5 ft.
 scribed, W1/16 S31 BT

Found a Pine, 10" dia., dead & standing, bears N55W., 33.0 ft.,
 scribed, W1/16 S31 BT

Description of monument and accessories | established to perpetuate the
 original location of this corner:

Maintained corner by setting steel posts with warning and boundary
 signs East & West 3 ft. from cor.

Maintained Accessories as follows:
 Scribed a New Bearing tree, A Fir. 10" dia. Bears N 1E., 39.1 ft.
 scribed W1/16 S31 BT.
 Nailed a brass washer stamped PLS 848, on blaze above BT scribe on new tree
 Bearing Tree Sign above blaze, and warning sign on back of each tree.
 Painted a 6" red band at breast ht. around each tree.
 (Douglas M. Ferguson, PLS 848 scribed new tree)

REGISTERED
 PROFESSIONAL
 LAND SURVEYOR

J. David Brinton

OREGON
 DECEMBER 2, 1983
 J. DAVID BRINTON
 2065

Corner maintained Sept. 15, 1984
 Witnessed by Douglas M. Ferguson, PLS 848

Office of..... County of.....
 State of....., I hereby certify that the within instrument was filed in this office
 for record on the..... day of....., 19.....
 by
 (COUNTY OFFICIAL) (DEPUTY)

FILED 2-15-85
 BAKER COUNTY SURVEYOR
 SURVEY NO. 7-38-56