

History of original corner establishment:

Corner originally established in 1881, by Eugene P. McCornack, under "General Land Office Contract" No. 398, Surveyor General's Notes State:

Set post 3 ft. long 3 ins sq. 24 ins. in the ground for 1/4 Sec. cor. mkd. 1/4 on W face. from which:

A Fir 48 ins. diam bears N35W 43 lks. dist. mkd. 1/4 S BT

A Fir 24 ins. diam bears S45E 42 lks. dist. mkd. 1/4 S BT

In 1978 the Bureau of Land Management Performed A Dependent Resurvey of A portion of the South Boundary of T.7B., R.38E., under special instructions, dated March 13, 1978, approved March 28, 1978. The Notes from that survey, as executed by Dale T. Bedell, cadastral surveyor, state:

(Abridged Notes) Set Corner at record measurements from remains of original bearing trees. Set standard monument mkd. (see DIAGRAM) from which:

A larch, 8 ins. diam., bears N. 6W., 40-1/2 lks. dist., mkd. 1/4 S32 BT

A fir 10 ins. diam. bears S.75E., 20 lks. dist., mkd. 1/4 S5 BT

Description of corner evidence found:

Found 2-1/2" iron pipe with 3" brass cap stamped as shown on the DIAGRAM set with 6" above the ground.

Found original bearing trees as follows:

A root hole, bears N35W., 43 lks. dist. with down and decayed fir alongside, 40 ins. diam., with axe marks and decayed blaze.

A root hole, bears S45E., 42 lks. dist., with a down fir alongside, 28 ins. diam., with axe marks on bark.

Found trees taken by the BLM in 1978, live in good condition, with scribing visible, at record measurement, A tamarack 10" in diam., and a fir 11" in diam.


Description of monument and accessories I established to perpetuate the original location of this corner:

Maintained Corner monument by setting a steel post with warning sign East 1 ft. from the corner.

Maintained Accessories as follows:

The original trees are painted on the solid wood and bearing tree & warning signs are nailed to each tree.

Trees taken by the BLM in 1978 are painted with a 6" red band and warning signs nailed to the back of each tree.

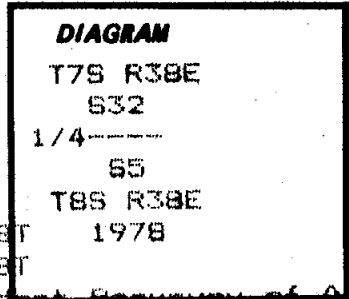

REGISTERED
PROFESSIONAL
LAND SURVEYOR

J David Brinton

OREGON
DECEMBER 2, 1983
J. DAVID BRINTON
2065

Corner Maintained Sept. 15, 1984
Witnessed by Douglas M. Ferguson, PLS 848

Office of..... County of.....

State of....., I hereby certify that the within instrument was filed in this office
for record on the..... day of....., 19.....

..... by
(COUNTY OFFICIAL) (DEPUTY)