

History of original corner establishment:

In 1978 the Bureau of Land Management Performed A Dependent Resurvey of A portion of the South Boundary of T.7S.,R.38E., under special instructions, dated March 13, 1978, approved March 28, 1978. The Notes from that survey, as executed by Dale T. Bedell, cadastral surveyor, state: Set an iron post, 28 ins. long, 2-1/2 ins. diam., 22 ins. in the ground, with brass cap mkd. (see DIAGRAM from which

DIAGRAM

(not on cap)
(T7S R38E)
S32
E1/16----
S 5
(T8S R38E)
1978

A Pine, 11 ins. diam., bears N.41E., 17 lks. dist., mkd. E1/16 S32 BT
A larch, 13 ins. diam., bears S.42E., 49 lks. dist., mkd. E1/16 S 5 BT

Description of corner evidence found:

Found 2-1/2" iron pipe with 3" brass cap, stamped as shown on the diagram, set with 6" above the ground.

Found Sec 32 Bearing tree, A pine, 11" dia., dead and standing, with scribing visible, bears record measurement.

Found Sec 5 Bearing tree, A larch, 14" dia., live, in good condition, at record measurement, with scribing visible.

Description of monument and accessories | established to perpetuate the

original location of this corner:

Maintained Corner monument by setting a steel post with warning sign East 1 ft. from pipe.

Maintained bearing trees taken by BLM in 1978 by painting a 6" red band around each tree and nailing Warning signs to the back of each tree.

Nailed a bearing tree sign to Sec 5 tree.


Scribed a New Bearing Tree, a Fir, 12" dia. bears N48E., 75.0 ft.

scribed E1/16 S32 BT.


Nailed a brass washer stamped PLS 848, on blaze above BT scribe, Bearing Tree Sign above blaze, and warning sign on back of new tree.

Painted a 6" red band at breast ht. around new tree.

(Douglas M. Ferguson, PLS 848 scribed the new tree)

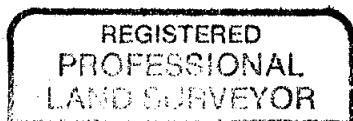

J. David Brinton

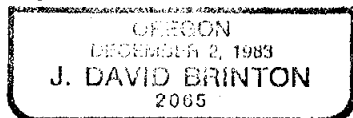

Corner Maintained Sept. 15, 1984
Witnessed by Douglas M. Ferguson PLS 848

Office of..... County of.....

State of....., I hereby certify that the within instrument was filed in this office

for record on the..... day of....., 19.....

..... by

(COUNTY OFFICIAL)

(DEPUTY)