


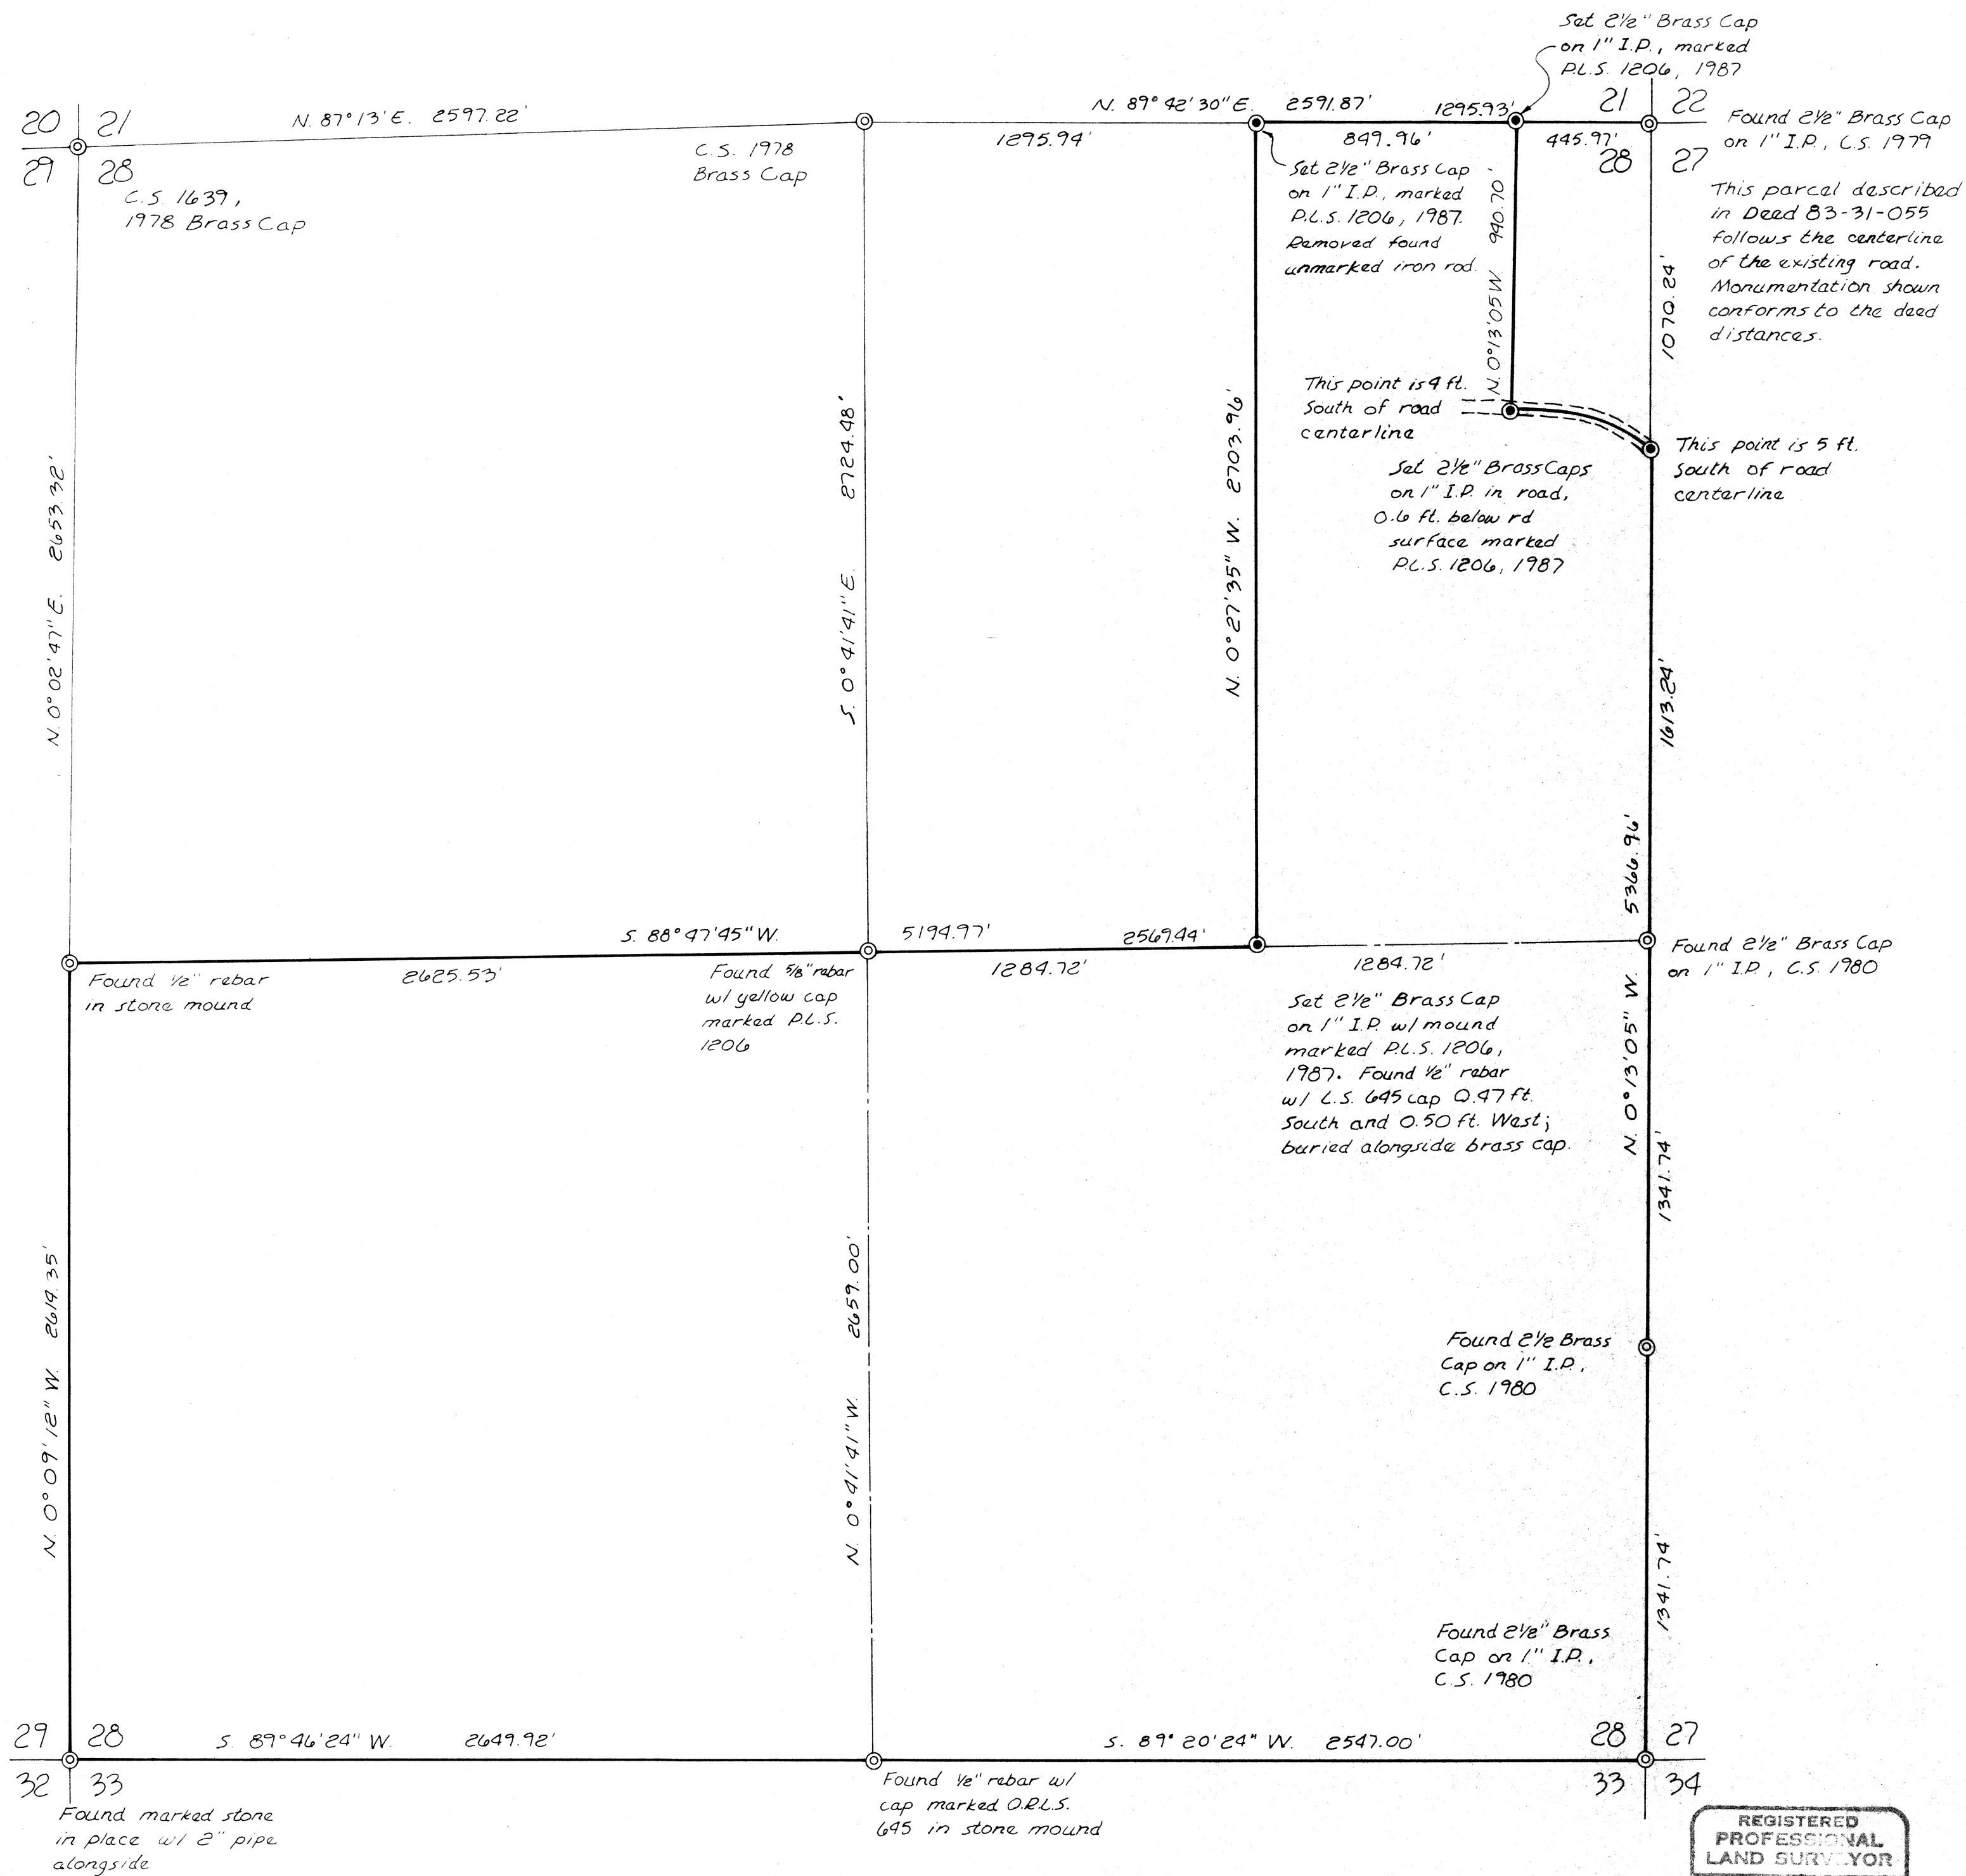

LEGEND

● Set 2 1/2" Brass Cap on 1" I.P., marked P.L.S. 1206, 1987

⊙ Found monument of record

NOTE: Heavier boundary lines are posted this survey with steel fence posts



NARRATIVE:

This survey for the Oregon Department of Fish and Wildlife was made for the purpose of marking on the ground the property lines as shown. Standard survey practices employed

REFERENCE SURVEYS:

7-38-9 7-38-10
7-38-17 7-38-28

MAP OF SURVEY

A PARCEL IN SECTION 28,
T. 7 S., R. 38 E., W.M.

REGISTERED
PROFESSIONAL
LAND SURVEYOR

James D. Hanley
OREGON
JAMES D. HANLEY
1286

FOR OREGON DEPARTMENT OF FISH AND WILDLIFE

March - June, 1987 FIELD 6-22-87

SCALE 1" = 400' BAKER COUNTY SURV

SURVEY NO. 7-38-63