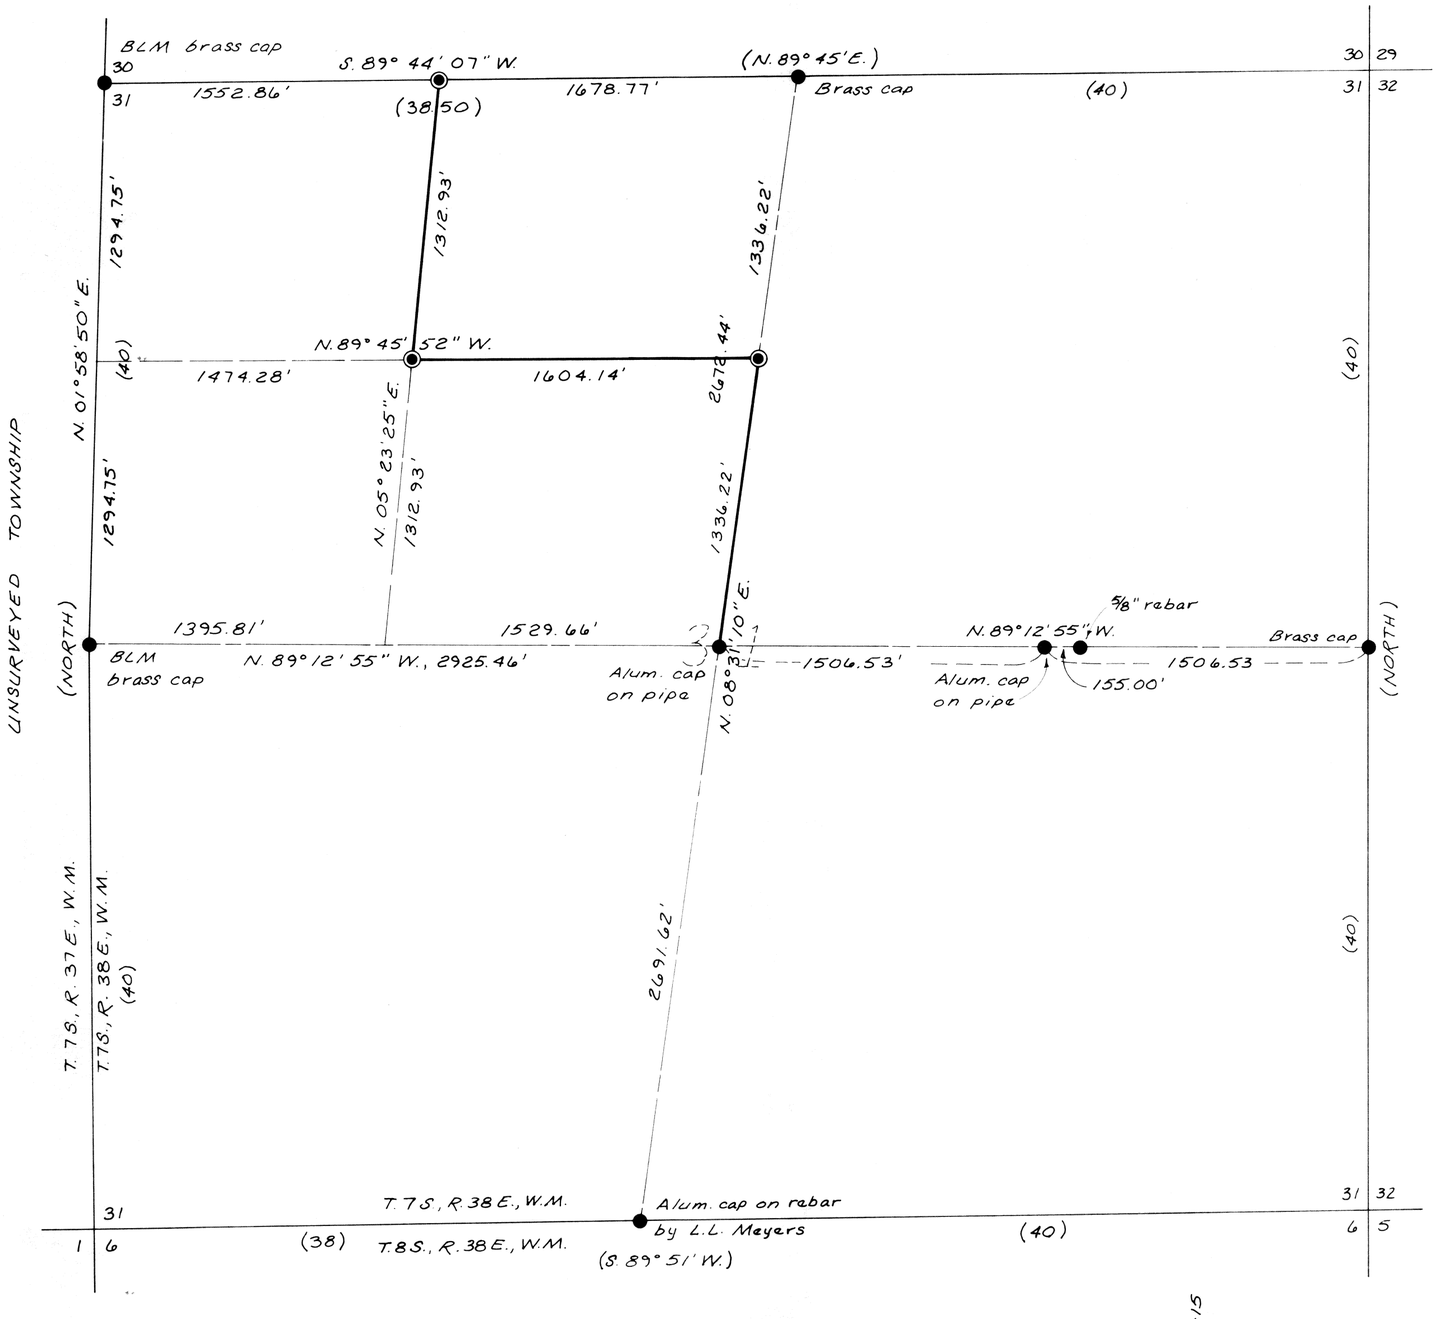

MAP OF SURVEY
IN THE NW 1/4 SECTION 31
T. 7S., R. 38E., W.M.

SURVEYED JUNE, 1990 1" = 500'

FOR

EARL SUITTER

BASIS OF BEARING
SURVEYS 7-38-6, 7-38-15

NARRATIVE

THIS SURVEY FOR EARL SUITTER WAS PERFORMED FOR THE PURPOSE OF MARKING ON THE GROUND THE PROPERTY LINE SHOWN HEREON. THE SUBDIVISION OF SECTION 31 WAS RETRACED, SHOWN MONUMENTS WERE RECOVERED AND THE NORTHWEST QUARTER THEREOF WAS FURTHER SUBDIVIDED. BRASS CAP MONUMENTS WERE SET AT THE PROPERTY CORNERS HEREON AND PROPERTY LINES WERE MARKED WITH STEEL FENCE POSTS.

LEGEND

- ◉ Set 2½" brass cap on 1" iron pipe
- ● Monument of record, as noted
- —— Property line marked w/ steel fence posts

James E. Hanley

HANLEY ENGINEERING
BAKER CITY, OREGON

FILED JULY 2, 1990
BAKER COUNTY SURVEYOR
SURVEY NO. 7-38-66