

CERTIFIED RECORD OF LAND CORNER MONUMENTATION

HISTORY OF ORIGINAL CORNER ESTABLISHMENT:

Corner originally established by Timothy W. Davenport under GLO contract number 102, dated July 20, 1863. Surveyor General records states:

Set qr. sec post, made mound of earth and drove charred stake as per inst.

DESCRIPTION OF CORNER EVIDENCE FOUND:

Found no evidence of the GLO Corner monument or accessories.

See Survey dated May 20, 2002 for Wes Williams

DESCRIPTION OF MONUMENT AND ACCESSORIES I ESTABLISHED
TO PERPETUATE THE ORIGINAL LOCATION OF THIS CORNER:

At a position determined by survey, I set a 2 1/2"x 30" aluminum pipe with aluminum cap marked as shown below, 28" in the ground, from which;

NEW BEARING OBJECTS:




A 5/8"x30" iron pin with 1 1/2" aluminum cap marked "BGB SURVEY MARKER NE RP" bears North 86°11' East, a distance of 3.89 feet. (In E-W Fence)

A 5/8"x30" iron pin with 1 1/2" aluminum cap marked "BGB SURVEY MARKER SE RP" bears South 19°46' East, a distance of 18.11 feet. (On South bank of irrigation ditch)

A 5/8"x30" iron pin with 1 1/2" aluminum cap marked "BGB SURVEY MARKER SW RP" bears South 64°21' West, a distance of 39.43 feet. (On South bank of irrigation ditch)

A 5/8"x30" iron pin with 1 1/2" aluminum cap marked "BGB SURVEY MARKER NW RP" bears North 80°49' West, a distance of 3.32 feet. (In E-W Fence)

I hereby certify that the corner was monumented on May 16, 2002.
Witness: Greg T. Blackman Jr.

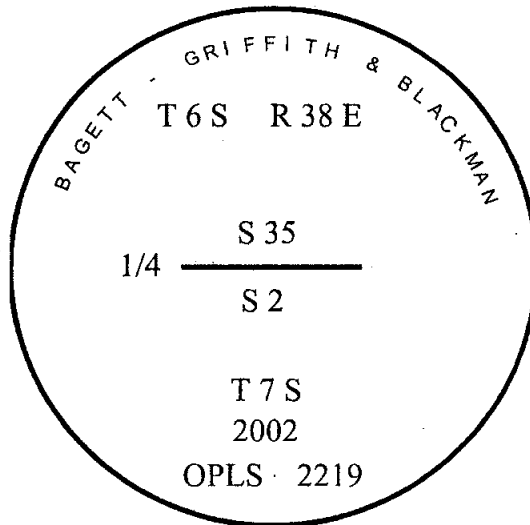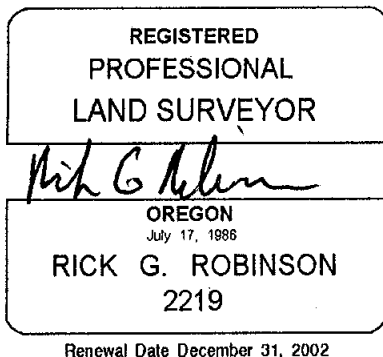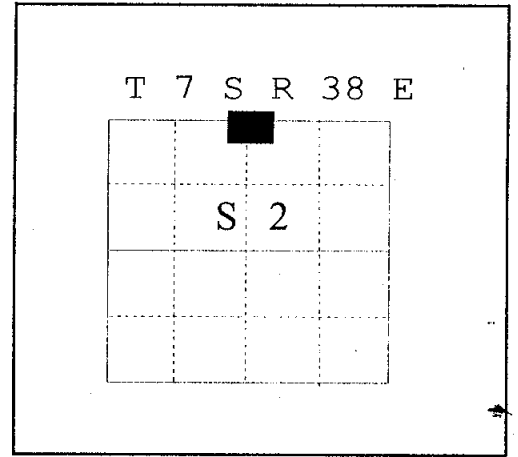

I used a Leica 530 GPS system with the Basis of Bearing being the same as Survey dated May 20, 2002 for Wes Williams in establishment of the new accessories. The distances are to the center of cap.

FILED MAY 22, 2002
BAKER COUNTY SURVEYOR
SURVEY NO. 6-38-26
7-38-79
CP # 82

A-19