

GOVERNMENT CORNER RECORD

Township 7S Range 38E Section 12 County BAKER

State OREGON Date NOVEMBER 18, 2003 Number G-25

Corner Designation : FOUND CORNER ACCEPTED AS THE
1/4 CORNER SECTIONS 12 AND 7

Previous Renewals _____

Monument (s) Found: (Condition and Source)

FOUND BRASS CAP MONUMENT ACCEPTED AS THE 1/4 CORNER
BETWEEN SECTION 12 & 7. AS PER COUNTY SURVEY NO.
7-38-8.

Accessories Found:

NONE


Monument & Accessories Set (Procedure and Description)

SET A 5/8" X 24" REBAR AND 2" ALUMINUM CAP AT PREVIOUS POSITION OF A BRASS CAP MARKED SIMILAR
AND ACCEPTED AS THE 1/4 CORNER BETWEEN SECTIONS 12 & 7. RESET FROM TIES MADE DURING THE
RECONSTRUCTION OF ANTHONY LAKES HWY. TIES MADE TO CONTROL NETWORK FOR HWY. CONTROL. SET P.K.
NAIL TIES IN ALL FOUR QUADRANTS AS SHOWN BELOW.


____ Condition Report Only
____ Not Found
☒ Renewed
____ Surveyed In
☒ Referenced

MONUMENT DETAIL

____ Found ☒ Set

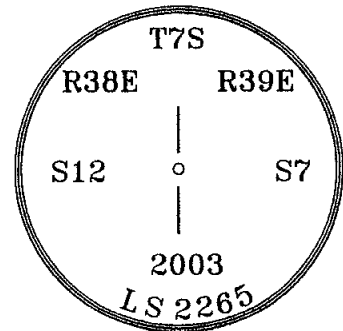

Sketch of Monument, Accessories and General Area

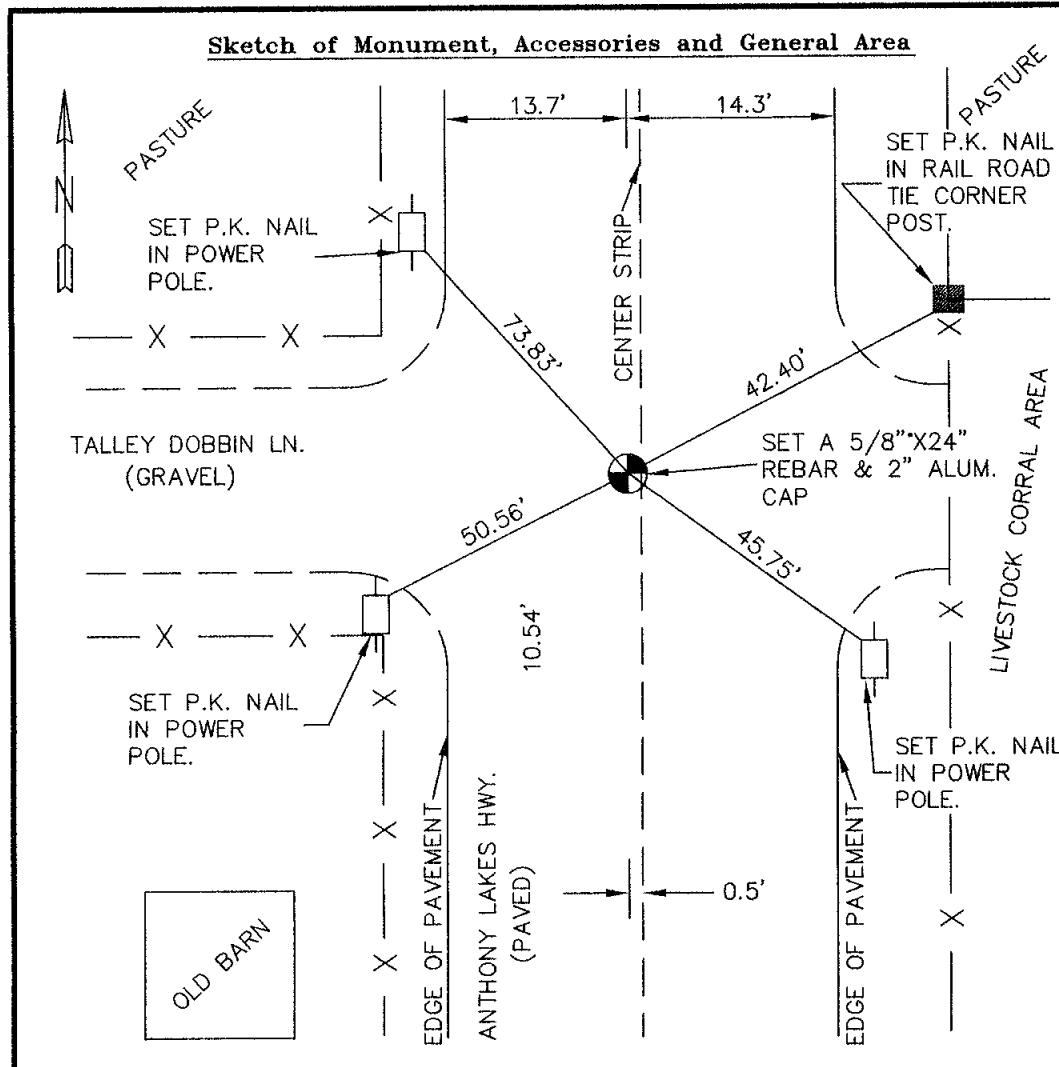

Surveyor's Seal

**REGISTERED
PROFESSIONAL
LAND SURVEYOR**

Randy H. Scott
**OREGON
JAN. 21, 1988
RANDY SCOTT
2265**

RENEWAL DATE : 6-30-04

Surveyors Address:
14550 S.W. Rock Creek Rd.
Sheridan, OR 97378
Party Chief L. KING
Note keeper L. KING
Witness(s) C. KING
FIELD BOOK 0-199 PG. 123
JOB No. OR-03005

**COUNTY SURVEYOR
RECORDING INFO**

Received APRIL 21, 2004

Filed APRIL 21, 2004

Survey No. 7-38-86

Drawing No. 7-39-53

Index No. CP#110