


CORNER RESTORATION

CORNER: CW 1/16 SEC. 17, TWP. 7 S., RANGE 38 E., W.M.

ORIGINAL SURVEY BY: NOT

SURVEY NUMBER: PREVIOUSLY

DATE: ESTABLISHED

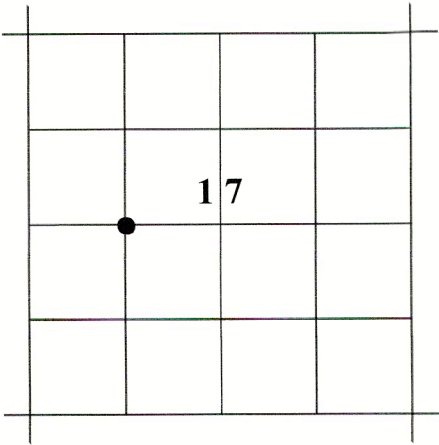

ORIGINAL DESCRIPTION: NONE

RESTORATION BY, STAMP AND DATE:

Jason L. Hatfield, PLS
Michael C. Springer, PLS

July 29, 2011

See Record Map of Survey No. 7-38-90




DESCRIPTION OF MONUMENTS AND ACCESSORIES SET AND METHODS USED:

At the corner point as located by survey, we set a 5/8"x30" iron pin 29" in the ground, with attached 2" diameter aluminum cap marked as shown.

From which, I SET THE FOLLOWING REFERENCE POINTS:

- ▶ A 5/8"x30" iron pin bears N41°20'E, 21.02 ft., with attached yellow plastic cap marked "BENCHMARK SURVEYING"
- ▶ A 5/8"x30" iron pin bears S40°35'E, 30.57 ft., with attached yellow plastic cap marked "BENCHMARK SURVEYING"

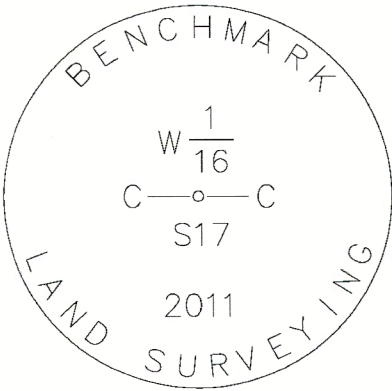

Used a total station to measure the reference points. Bearings are based on Record Map of Survey No. 7-38-90.

FILED Aug. 9, 2011
BAKER COUNTY SURVEYOR
SURVEY NO. 7-38-9A