


# CORNER RESTORATION

**CORNER:** C 1/4 SEC. 17, TWP. 7 S., RANGE 38 E., W.M.

**ORIGINAL SURVEY BY:** NOT

**SURVEY NUMBER:** PREVIOUSLY

**DATE:** ESTABLISHED

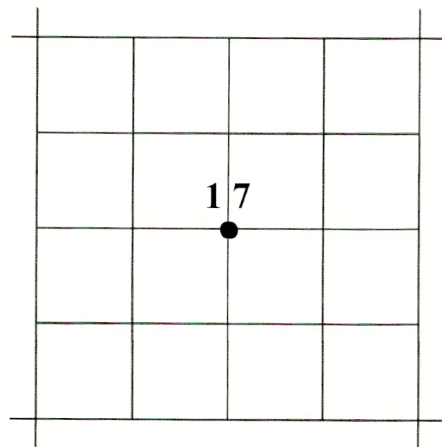

**ORIGINAL DESCRIPTION:** NONE

**RESTORATION BY, STAMP AND DATE:**

Jason L. Hatfield, PLS  
Michael C. Springer, PLS

July 21, 2011

**See Record Map of Survey No. 7-38-90**



## DESCRIPTION OF MONUMENTS AND ACCESSORIES SET AND METHODS USED:

At the corner point as located by survey, we set a 5/8"x30" iron pin 29" in the ground, with attached 2" diameter aluminum cap marked as shown, and built a 2 foot mound of stone.

From which, **I SET THE FOLLOWING REFERENCE POINTS:**

- ▶ A 5/8"x30" iron pin bears S04°05'E, 26.21 ft., with attached yellow plastic cap marked "BENCHMARK SURVEYING"
- ▶ A 5/8"x30" iron pin bears S54°50'W, 20.17 ft., with attached yellow plastic cap marked "BENCHMARK SURVEYING"

I also **SCRIBED BEARING TREES:**

- ▶ An 8" DBH Englemann spruce bears N80°E, 5.33 ft., marked T7S R38E 1/4 S17 BT
- ▶ A 6" DBH white fir bears N66°W, 12.38 ft., marked C1/4 S17 BT

Used a total station to measure the accessories. The distances to the bearing trees were measured to a 50d nail driven into the side center at the root crown of each tree. Attached yellow aluminum Bearing Tree tags to the trees. Bearings are based on Record Map of Survey No. 7-38-90.



FILED Aug 9, 2011  
BAKER COUNTY SURVEYOR  
SURVEY NO. 7-38-95