

CORNER RESTORATION

CORNER: EAST 1/4 SEC. 17, TWP. 7 S., RANGE 38 E., W.M.


ORIGINAL SURVEY BY: William R. Gradon, U.S. Deputy Surveyor

CONTRACT NUMBER: 445

CONTRACT DATE: June 1, 1882

SUBSEQUENT SURVEYS:

- ▶ Baker County Survey No. 7-38-2, by James Hanley, PE, filed September 5, 1973
- ▶ Baker County Survey No. 7-38-12, by William Hanley, PLS, filed December 4, 1978.

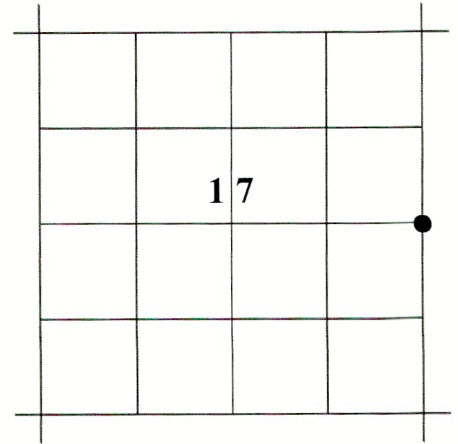

ORIGINAL DESCRIPTION: *Set a post, 3 ft. long, 3 ins. square, 24 ins in the ground for 1/4 sec. cor. marked 1/4S on W face, from which A pine 14 ins diam. bears S80°E 24 lks dist, marked 1/4S B.T. A pine 12 ins diam bears West 23 lks dist, marked 1/4S B.T.*

James Hanley and William Hanley both accepted a fence intersection for the 1/4 corner position.

RESTORATION BY, STAMP AND DATE:

Jason L. Hatfield, PLS
Michael C. Springer, PLS

July 14, 2011

See Record Map of Survey No. 7-38-90




EVIDENCE FOUND: We found a fence corner intesection with fences extending North, South and East. We searched for, but found no remaining evidence of the original wood post or the original bearing trees. I accept the fence corner as the best available evidence of the position of the 1/4 corner.

DESCRIPTION OF MONUMENTS AND ACCESSORIES SET AND METHODS USED:

At the corner point, we set a 5/8"x30" iron pin 30" in the ground with attached 2" diameter aluminum cap marked as shown, and built a small mound of stone.

From which, I SET THE FOLLOWING REFERENCE POINTS:

- ▶ A 5/8"x30" iron pin bears North, 11.63 ft., with attached yellow plastic cap marked "BENCHMARK SURVEYING" in north-south fenceline.
- ▶ A 5/8"x30" iron pin bears East, 28.04 ft., with attached yellow plastic cap marked "BENCHMARK SURVEYING" in east-west fenceline.
- ▶ A 5/8"x30" iron pin bears South, 36.52 ft., with attached yellow plastic cap marked "BENCHMARK SURVEYING" in north-south fenceline.
- ▶ A 5/8"x30" iron pin bears West, 22.09 ft., with attached yellow plastic cap marked "BENCHMARK SURVEYING"

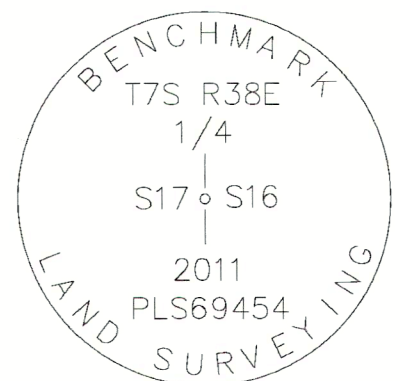

Used a magnetic compass with 15° East declination and a steel tape to measure accessories. Attached a yellow aluminum Corner Location tag to the fence post.

FILED Aug. 9, 2011
BAKER COUNTY SURVEYOR
SURVEY NO. 7-38-96