


CORNER RESTORATION

CORNER: CS 1/16 SEC. 17, TWP. 7 S., RANGE 38 E., W.M.

ORIGINAL SURVEY BY: NOT

SURVEY NUMBER: PREVIOUSLY

DATE: ESTABLISHED

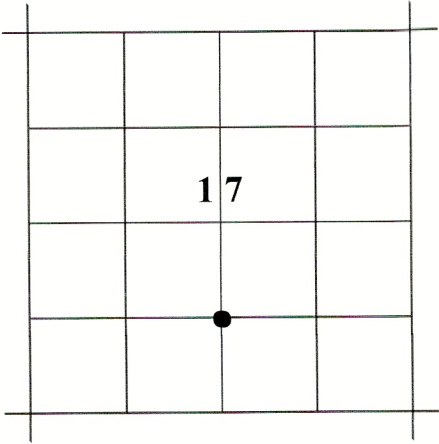

ORIGINAL DESCRIPTION: NONE

RESTORATION BY, STAMP AND DATE:

Jason L. Hatfield, PLS
Michael C. Springer, PLS

July 21, 2011

See Record Map of Survey No. 7-38-90



DESCRIPTION OF MONUMENTS AND ACCESSORIES SET AND METHODS USED:


At the corner point as located by survey, we set a 5/8"x30" iron pin 29" in the ground, with attached 2" diameter aluminum cap marked as shown, and built a small mound of stone.

From which, I SET THE FOLLOWING REFERENCE POINT:

- ▶ A 5/8"x30" iron pin bears N77°38'E, 27.64 ft., with attached yellow plastic cap marked "BENCHMARK SURVEYING"

I also SCRIBED A BEARING TREE:

- ▶ A 22" DBH ponderosa pine bears S83°W, 8.8 ft., marked S17 BT

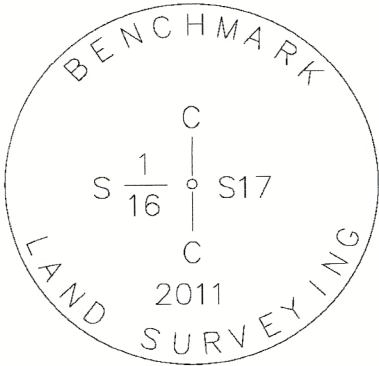

Used a total station to measure the accessories. The distance to the bearing tree was measured to a 50d nail driven into the side center at the root crown of the tree. Attached a yellow aluminum Bearing Tree tag to the tree. Bearings are based on Record Map of Survey No. 7-38-90.

FILED Aug. 9, 2011

BAKER COUNTY SURVEYOR

SURVEY NO. 7-38-98