


CORNER RESTORATION

CORNER: S1/16 SEC. 17, TWP. 7 S., RANGE 38 E., W.M.

ORIGINAL SURVEY BY: NOT

SURVEY NUMBER: PREVIOUSLY

DATE: ESTABLISHED

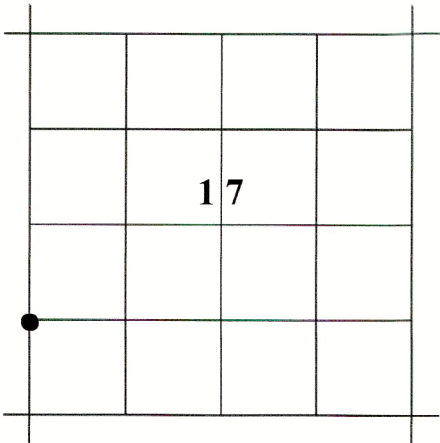


ORIGINAL DESCRIPTION: NONE

RESTORATION BY, STAMP AND DATE:

Jason L. Hatfield, PLS  
Michael C. Springer, PLS

June 5, 2013

See Record Map of Survey No. 7-38-100

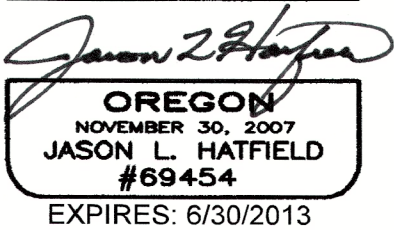

DESCRIPTION OF MONUMENTS AND ACCESSORIES SET AND METHODS USED:


At the corner point as located by survey, we set a 5/8"x30" iron pin 29" in the ground, with attached 2" diameter aluminum cap marked as shown and built a small mound of stone.

From which, I SET THE FOLLOWING REFERENCE POINT:

- ▶ A 5/8"x30" iron pin bears N.35°19'E., 22.66 ft., with attached yellow plastic cap marked "BENCHMARK SURVEYING"

I also SCRIBED A BEARING TREE:

- ▶ A 10.2" DBH Englemann spruce bears S.10°W., 3.9 ft., marked 1/16 BT

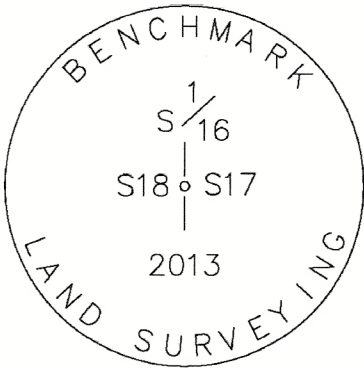

Used a total station to measure the bearing and distance to the RP. The distance to the bearing tree was measured using a steel tape, measuring to a 50d nail driven into the side center at the root crown of the tree. Bearing to the tree was obtained with a magnetic compass with 15° East Declination. Attached a yellow aluminum Bearing Tree tag to the tree.

FILED June 17, 2013

BAKER COUNTY SURVEYOR

SURVEY NO. 7-38-101