


CORNER RESTORATION

CORNER: W1/16 SEC. 17, TWP. 7 S., RANGE 38 E., W.M.

ORIGINAL SURVEY BY: NOT

SURVEY NUMBER: PREVIOUSLY

DATE: ESTABLISHED

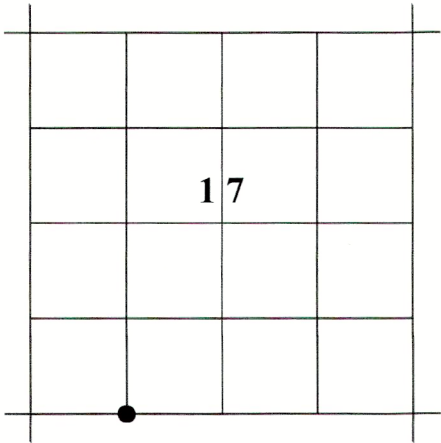


ORIGINAL DESCRIPTION: NONE

RESTORATION BY, STAMP AND DATE:

Jason L. Hatfield, PLS

June 6, 2013

See Record Map of Survey No. 7-38-100

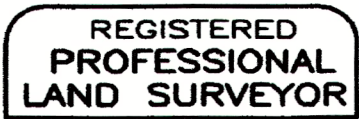

DESCRIPTION OF MONUMENTS AND ACCESSORIES SET AND METHODS USED:

At the corner point as located by survey, I set a 5/8"x30" iron pin 29" in the ground, with attached 2" diameter aluminum cap marked as shown and built a small mound of stone.

From which, I SET THE FOLLOWING REFERENCE POINT:

- ▶ A 5/8"x30" iron pin bears N.87°04'W., 61.24 ft., with attached yellow plastic cap marked "BENCHMARK SURVEYING"

I also SCRIBED A BEARING TREE:

- ▶ A 5.3" DBH Douglas-fir bears S.42°24'W., 25.1 ft., marked 1/16 BT



Used RTK GPS to measure the accessories. The distance to the bearing tree was measured to a 50d nail driven into the side center at the root crown of the tree. Attached a yellow aluminum Bearing Tree tag to the tree. Bearings are based on Record Map of Survey No. 7-38-100.

FILED June 17, 2013
BAKER COUNTY SURVEYOR
SURVEY NO. 7-38-102