


**CERTIFIED RECORD OF LAND CORNER MONUMENTATION**

**History of original corner establishment:**

Original corner set by Eugene P. McCormack, under GLO Contract No. 398, approved March 25, 1881.  
Record states: Set post 3 ft long 3 ins square 24 ins in the ground for 1/4 sec cor marked 1/4 S on W face. From which:  
A Hemlock, 8 ins. diam., bears N 50° E, 25 lks. dist., marked: 1/4S BT.  
A Hemlock, 10 ins. diam., bears N 80° W, 13 lks. dist., marked: 1/4S BT.


**Subsequent Monumentation**

Corner was remonumented by Lester E. Fischer and James J. Carlson, under BLM Group No. 350, approved June 13, 1977.  
Record states: The 1/4 sec. cor. of sec. 6 only, on the W. bdy. of the Tp., determined at record bearing and distance from the remains of the original bearing trees:  
A root hole, bears N. 50° E., 25 lks. dist., with a down fir alongside, size indeterminate, with scribe marks 1/4 S visible on open blaze. (Record, hemlock).  
At the corner point: Set an iron post, 28 ins. long 2 1/2 ins. diam., 20 ins. in the ground, to bedrock, with brass cap mkd (as shown below), from which a new bearing trees:  
A white fir, 6 ins. diam, bears N. 78 1/2° E., 49 lks. dist., mkd X BT.  
A white fir, 8 ins. diam, bears S. 46 1/4° E., 25 lks. dist., mkd 1/4 S6 BT.  
  
Corner was rehabilitated by J. David Brinton, LS 2065, as described by Survey No. 7-38-34, filed February 15, 1985, in the records of the Baker County Surveyor.  
Record states: Found 3" brass cap monument, on 2 1/2" iron pipe set 8" above the ground with cap stamped (as shown below).  
Found a white fir, 7" dia., bears N78-1/2E, 32.3 ft.blaze open scribe reads X BT  
Found a white fir, 8" dia., bears S46/1/4E [sic], 16.5 ft. dist., blaze open scribe reads 1/4 S6 BT.  
Both trees live in good condition. Found remains of original bearing trees as described by the BLM.

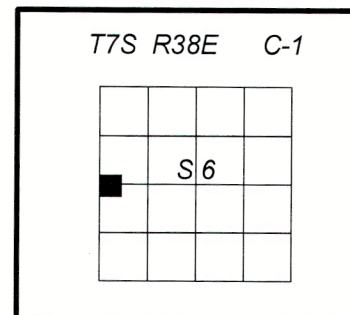

**Description of corner evidence found:**

Found 2 1/2 ins. diam. iron pipe, projecting 8 ins. above ground, no rocks in area for mound, with standard BLM 3 3/4 ins. diam. brass cap, marked as shown:  
  
From the recovered monument I find the Fischer bearing trees:  
A white fir stump, bears N. 78 1/2° E., 32.3 ft. dist. to face, with remains alongside and "1/4 S6 BT" visible on an open blaze.  
A white fir, 15 ins. diam. bears S. 46 1/4° E., 16.5 ft. dist. to face, alive and healthy, with healed blaze.  
  
Found guard posts ±5 ft. S'ly with Property Boundary (54-2) sign and ±5 ft. N'ly with Attention (54-4) and Property Boundary (54-2) signs attached.

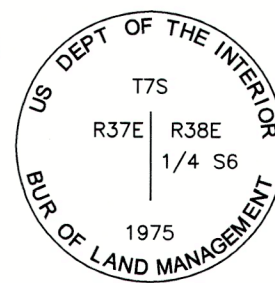

**Description of monument and accessories I established to perpetuate original location of this corner:**

New bearing trees:  
An Englemann spruce, 7 ins. diam., bears N. 31° E., 40.1 ft. dist., mkd. 1/4 S6 BT.  
An Englemann spruce, 6 ins. diam., bears N. 51° E, 49.6 ft. dist., mkd. X BT on double blaze.  
A white fir, 10 ins. diam., bears S.81° E., 31.0 ft. dist., mkd. 1/4 S6 BT.  
  
All new bearing trees are marked on a single blaze unless noted otherwise and have a nail with a brass washer stamped "LS 2648" right side center for distance measurements.  
  
Centerline of 2.5 ft. wide 6 ins. deep, Deer Creek courses E'ly ±15ft North of monument.  
  
Painted 6 ins. red bands and added Bearing Tree (54-3) and Land Survey Monument (54-9) signs as needed to all bearing trees.  
  
Auto C/A geographic position:  
Lat. 44°59'04.3" N  
Long. 118°06'56.7" W  
  
I hereby certify that the corner is monumented and accessories taken as described, using a Warren Knight staff compass, set with 15° East declination, and steel tape on September 10, 2014.  
  
Witnesses: Brenda Johnson and Justin Seal

REGISTERED  
PROFESSIONAL  
LAND SURVEYOR

**Deceased**

OREGON  
JANUARY 18, 1994  
RON C. WALTER  
2648

Renewal Date: June 30, 2016

REGISTERED  
PROFESSIONAL  
LAND SURVEYOR

*William R. Wells*

OREGON  
July 22, 1977  
WILLIAM R. WELLS  
1106

Renewal Date: June 30, 2016

FILED Feb. 25, 2015  
BAKER COUNTY SURVEYOR  
SURVEY NO. 7-37-3  
7-38-109

**NOTE:** See "Explanation for Successor Certifying Surveyor" statement in Narrative of Record of Survey, CS 7-38-107, filed concurrently with this Land Corner Record.