


# RECORD OF LAND CORNER MONUMENTATION

**CORNER:** N 1/16 COR. SECTION 34, TWP. 7 S., RANGE 38 E., W.M.

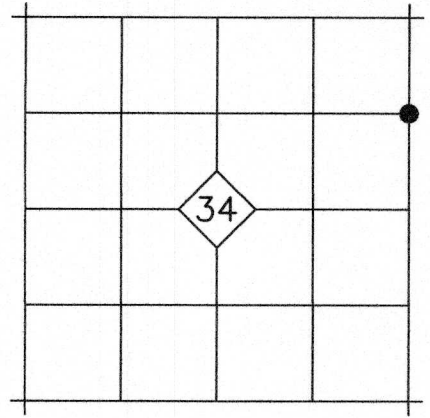

---

**ORIGINAL DESCRIPTION:** N/A

---

**EVIDENCE FOUND:** N/A

---

**DESCRIPTION OF MONUMENTS AND ACCESSORIES SET AND METHODS USED:**

At the corner point, as determined by survey, I set a 5/8"x30" iron pin with attached 2" aluminum cap 34" in the ground. The top of the cap is 4" below the asphalt surface. Cap is marked as shown below. This corner falls in the paved surface of Rock Creek Town Road, approximately 6 feet West of the existing centerline.

From which, I SET THE FOLLOWING REFERENCE POINTS:

- ▶ A 5/8"x30" iron pin bears EAST, 25.00 ft. with attached yellow plastic cap marked BENCHMARK SURVEYING
- ▶ A 5/8"x30" iron pin bears S.89°19'40"W., 15.00 ft. with attached yellow plastic cap marked BENCHMARK SURVEYING



Used RTK GPS to measure the reference points. Bearings are based on Baker County Survey No. 7-38-70.

---

**RESTORATION BY, STAMP AND DATE:**

Work Performed July 20, 2017 by:

Jason L. Hatfield, PLS

BENCHMARK LAND SURVEYING, INC.  
1207 Dewey Avenue  
Baker City, OR 97814  
(541)523-5852  
www.benchmarkls.com

FILED August 14, 2017  
BAKER COUNTY SURVEYOR  
SURVEY NO. 7-38-127

