


RECORD OF LAND CORNER MONUMENTATION

CORNER: SW1/16 COR. SECTION 34, TWP. 7 S., RANGE 38 E., W.M.

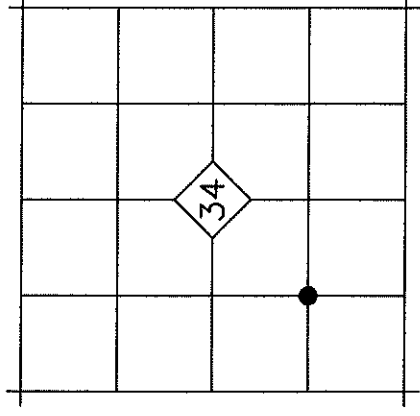

ORIGINAL DESCRIPTION: N/A

EVIDENCE FOUND: N/A

DESCRIPTION OF MONUMENTS AND ACCESSORIES SET AND METHODS USED:


At the corner point, as determined by survey, I set a 5/8"x30" iron pin with attached 2" aluminum cap 28" in the ground, and surrounded monument with a small mound of stones. Cap is marked as shown below.

From which, **I SET THE FOLLOWING REFERENCE POINT:**

- ▶ A 5/8"x30" iron pin bears S.60°48'E., 20.69 ft. with attached yellow plastic cap marked BENCHMARK SURVEYING

I ALSO SCRIBED THE FOLLOWING BEARING TREE:

- A 10.5" dbh Douglas fir, blazed and scribed *1/16 BT*, bears S.66°24'W., 26.70 feet from the corner

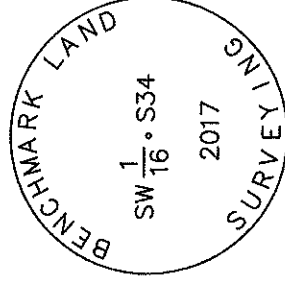

Used a total station to measure the accessories. Distance to bearing tree was measured to a 60d galv. nail driven in the side center at the root crown of the tree. Bearings are based on Baker County Survey No. 7-38-122. Attached a BT tag to the tree. Set a steel U post alongside monument.

RESTORATION BY, STAMP AND DATE:

Work Performed September 13, 2017 by:

Jason L. Hatfield, PLS
Nick N. Springer, Technician

BENCHMARK LAND SURVEYING, INC.
1207 Dewey Avenue
Baker City, OR 97814
(541)523-5852
www.benchmarkls.com



Jason L. Hatfield
OREGON
NOVEMBER 30, 2007
JASON L. HATFIELD
#69454

EXPIRES: 6/30/2019

FILED October 3, 2017

BAKER COUNTY SURVEYOR

SURVEY NO. 7-38-130