


# RECORD OF LAND CORNER MONUMENTATION

**CORNER:** NW 1/16 COR. SECTION 34, TWP. 7 S., RANGE 38 E., W.M.

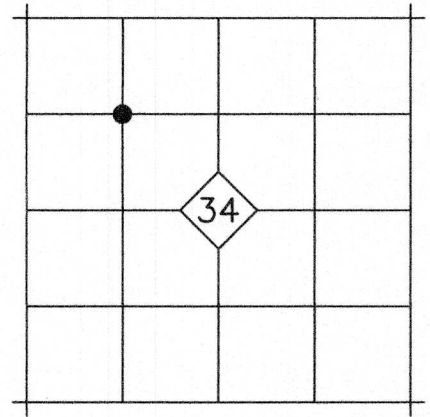

---

**ORIGINAL DESCRIPTION:** N/A

---

**EVIDENCE FOUND:** N/A

---

**DESCRIPTION OF MONUMENTS AND ACCESSORIES SET AND METHODS USED:**

At the corner point, as determined by survey, I set a 5/8"x30" iron pin 30" in the ground with attached 2" aluminum cap. Cap is marked as shown below.

From which, I SET THE FOLLOWING REFERENCE POINTS:

- ▶ A 5/8"x30" iron pin bears N.55°00'E., 33.61 ft. with attached yellow plastic cap marked BENCHMARK SURVEYING, set on the North side of an East-West wooden fence.
- ▶ A 5/8"x30" iron pin bears N.44°37'W., 26.35 ft. with attached yellow plastic cap marked BENCHMARK SURVEYING, set on the North side of an East-West wooden fence.



See Record Survey No. 7-38-122 for subdivision of Section 34

Used RTK GPS to measure the reference points.

---

**RESTORATION BY, STAMP AND DATE:**

Work Performed July 25, 2017 by:



Jason L. Hatfield, PLS

BENCHMARK LAND SURVEYING, INC.

1207 Dewey Avenue  
Baker City, OR 97814  
(541)523-5852

www.benchmarkls.com

FILED August 16, 2017  
BAKER COUNTY SURVEYOR  
SURVEY NO. 7-38-123

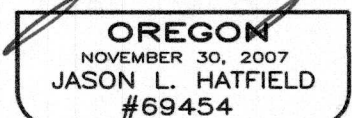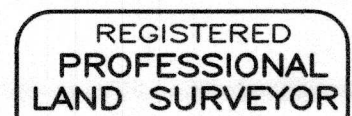

EXPIRES: 6/30/2019