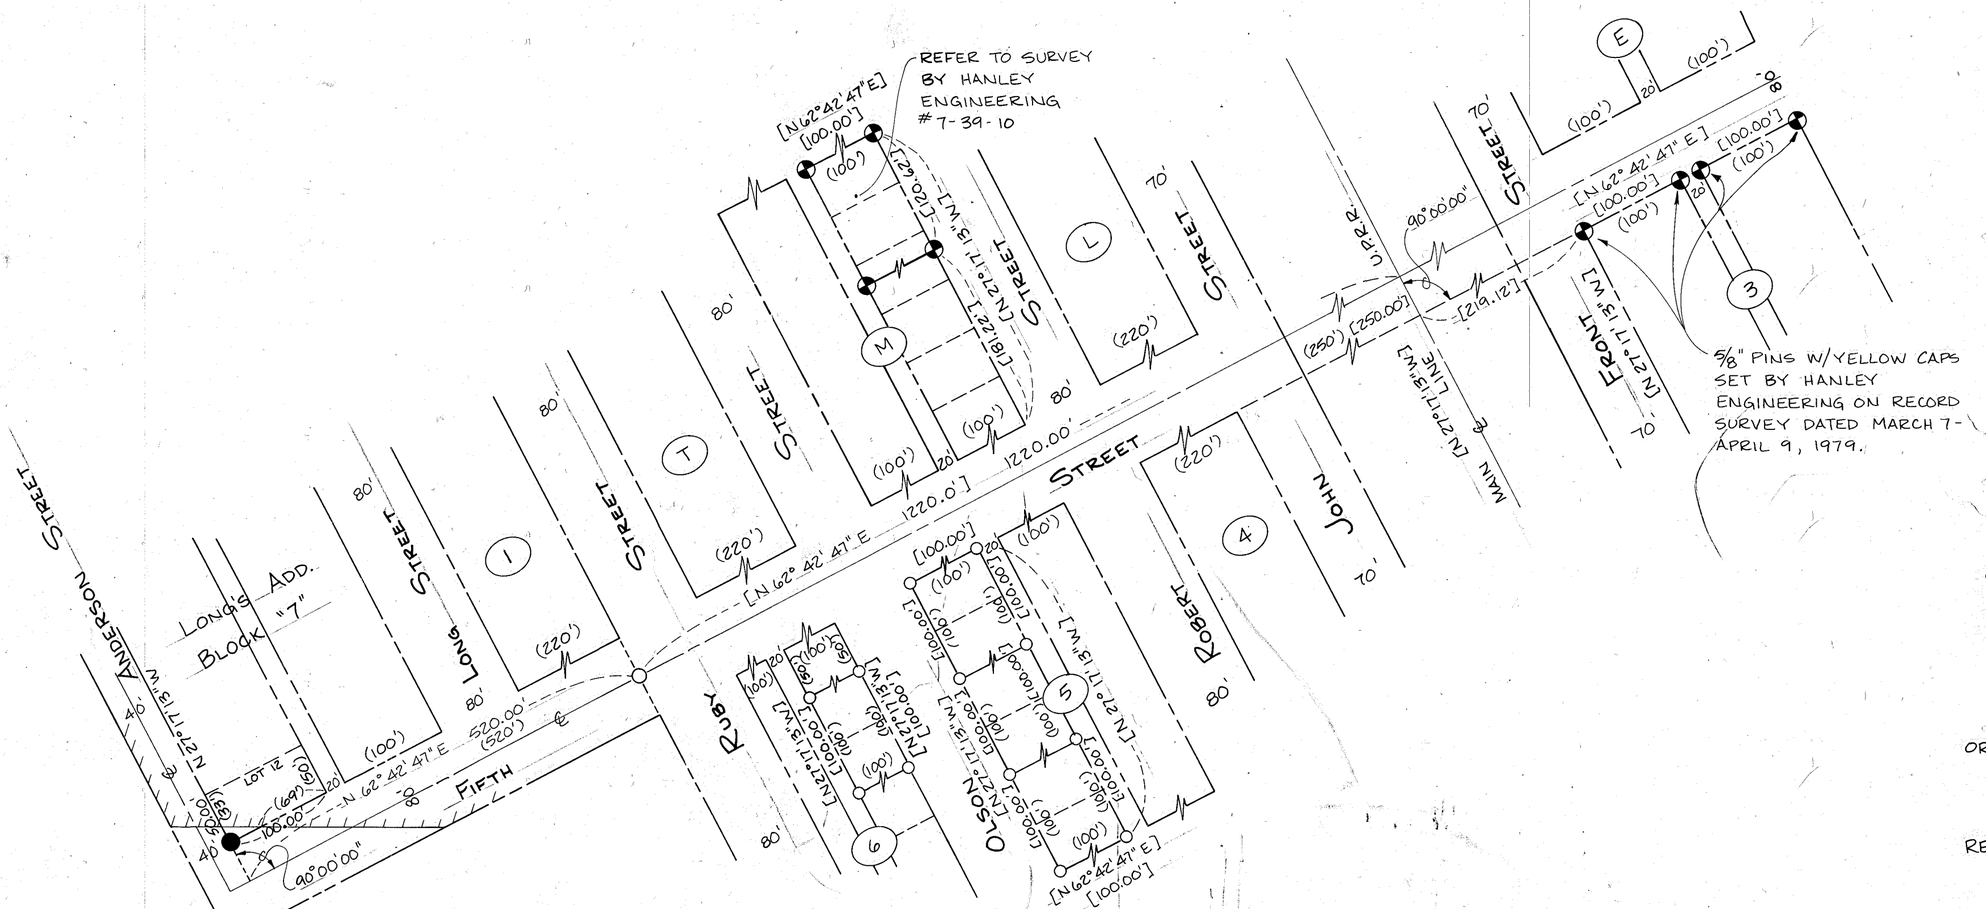

Basis of Bearing

& MAIN LINE U.P.R.R. BEING N27°17'13"W AS PER SURVEYS PERFORMED BY HANLEY ENGINEERING OCT. 2, 1978, APRIL 6, 1979, & APRIL 9, 1979.

Reference Material

ORIGINAL PLATS OF : HAINES TOWNSITE.
REVISED PLAT OF HAINES TOWNSITE.
LONGS ADDITION.

RECORD SURVEYS BY HANLEY ENGINEERING DATED OCTOBER 2, 1978, APRIL 6, 1979, & APRIL 9, 1979.

RECORD SURVEY BY ANDERSON · PERRY & ASSOC., INC. FOR N.E. OREGON HOUSING, APRIL 1981.

NARRATIVE

All of the original subdivisions and additions to Haines were designed with the northerly-southerly streets parallel to the centerline of the main line of the U.P.R.R. and the easterly-westerly streets perpendicular to the said centerline of the main line of the U.P.R.R. This survey extends Fifth Street and Anderson Street to make Block 7 a full block using record dimensions along Fifth Street. This is based on information received from Jim Hanley of Hanley Engineering who performed a control survey in Haines using what little original control that is left and tying in all existing parol evidence.

Legend

- FOUND MONUMENT OF RECORD AS SHOWN.
- SET 5/8" x 30" REBAR WITH YELLOW CAP STAMPED "A·P & A"
- FOUND MONUMENT SET ON RECORD SURVEY BY ANDERSON·PERRY & ASSOC., INC. FOR N.E. OREGON HOUSING, APRIL 1981.
- [·] RECORD DATA FROM RECORD SURVEYS SHOWN.
- ( ) RECORD SURVEY FROM ORIGINAL SUBDIVISION PLATS.
- (3) BLOCK NUMBER
- ORIGINAL SUBDIVISION LINE

REGISTERED PROFESSIONAL LAND SURVEYOR
OREGON
SEPTEMBER 23, 1977
HOWARD L. PERRY
1264

FILED April 29, 1981
BAKER COUNTY SURVEYOR
SURVEY NO. 7-39-23

S.W. CORNER OF BLOCK 7, LONG'S ADD. BASED ON EXTENSION OF ANDERSON & FIFTH STREETS. HAINES, BAKER COUNTY, OREGON.

FOR: CITY OF HAINES

SCALE:		SHEET NO.
1" = 100'	anderson perry & associates, inc.	1/1
DATE: APRIL, 1981	engineering · surveying · materials testing	
JOB NO. 705-02P	LA GRANDE, ORE. & WALLA WALLA, WASH.	