

MAP OF SURVEY

LOTS 1-4 OF BLOCK I, HAINES TOWNSITE, TOWN OF HAINES
 SW1/4NE1/4 & SE1/4NW1/4 OF SECTION 33, T7S, R39E, WM, BAKER COUNTY, OREGON

NARRATIVE

The purpose of this survey was to locate Lots 1, 2, 3 and 4 of Block 1, Revised Plat of Haines Townsite in the SW1/4NE1/4 & the SE1/4NW1/4 of Section 33, T7S, R39E, Baker County, Oregon, and set the four corners of the property for Cindy Hooker.


The monuments in the intersections of Third Street with John and Robert Streets were set by Baker County Survey No. 7-39-34 and used again during Survey No. 7-39-36. I used these two monuments to control this survey by turning perpendicular to the center of John Street. I found all improvements in the area to correspond with the measured and called distances. Nothing unusual was found and all record bearings and distances from the surveys shown above and the original subdivision plats were accepted.

CERTIFICATE

I, Leland Lee Myers, a Professional Land Surveyor registered in the State of Oregon, 587 E Auburn Street, PO Box 99, Sumpter, Oregon 97877, completed this survey on May 11, 2004, by setting the monuments and do hereby certify that the information shown on this plat is correct to the best of my knowledge.

REGISTERED
 PROFESSIONAL
 LAND SURVEYOR

 OREGON
 JULY 9, 1965
 LELAND LEE MYERS
 699
 Renewal Date 1/1/05

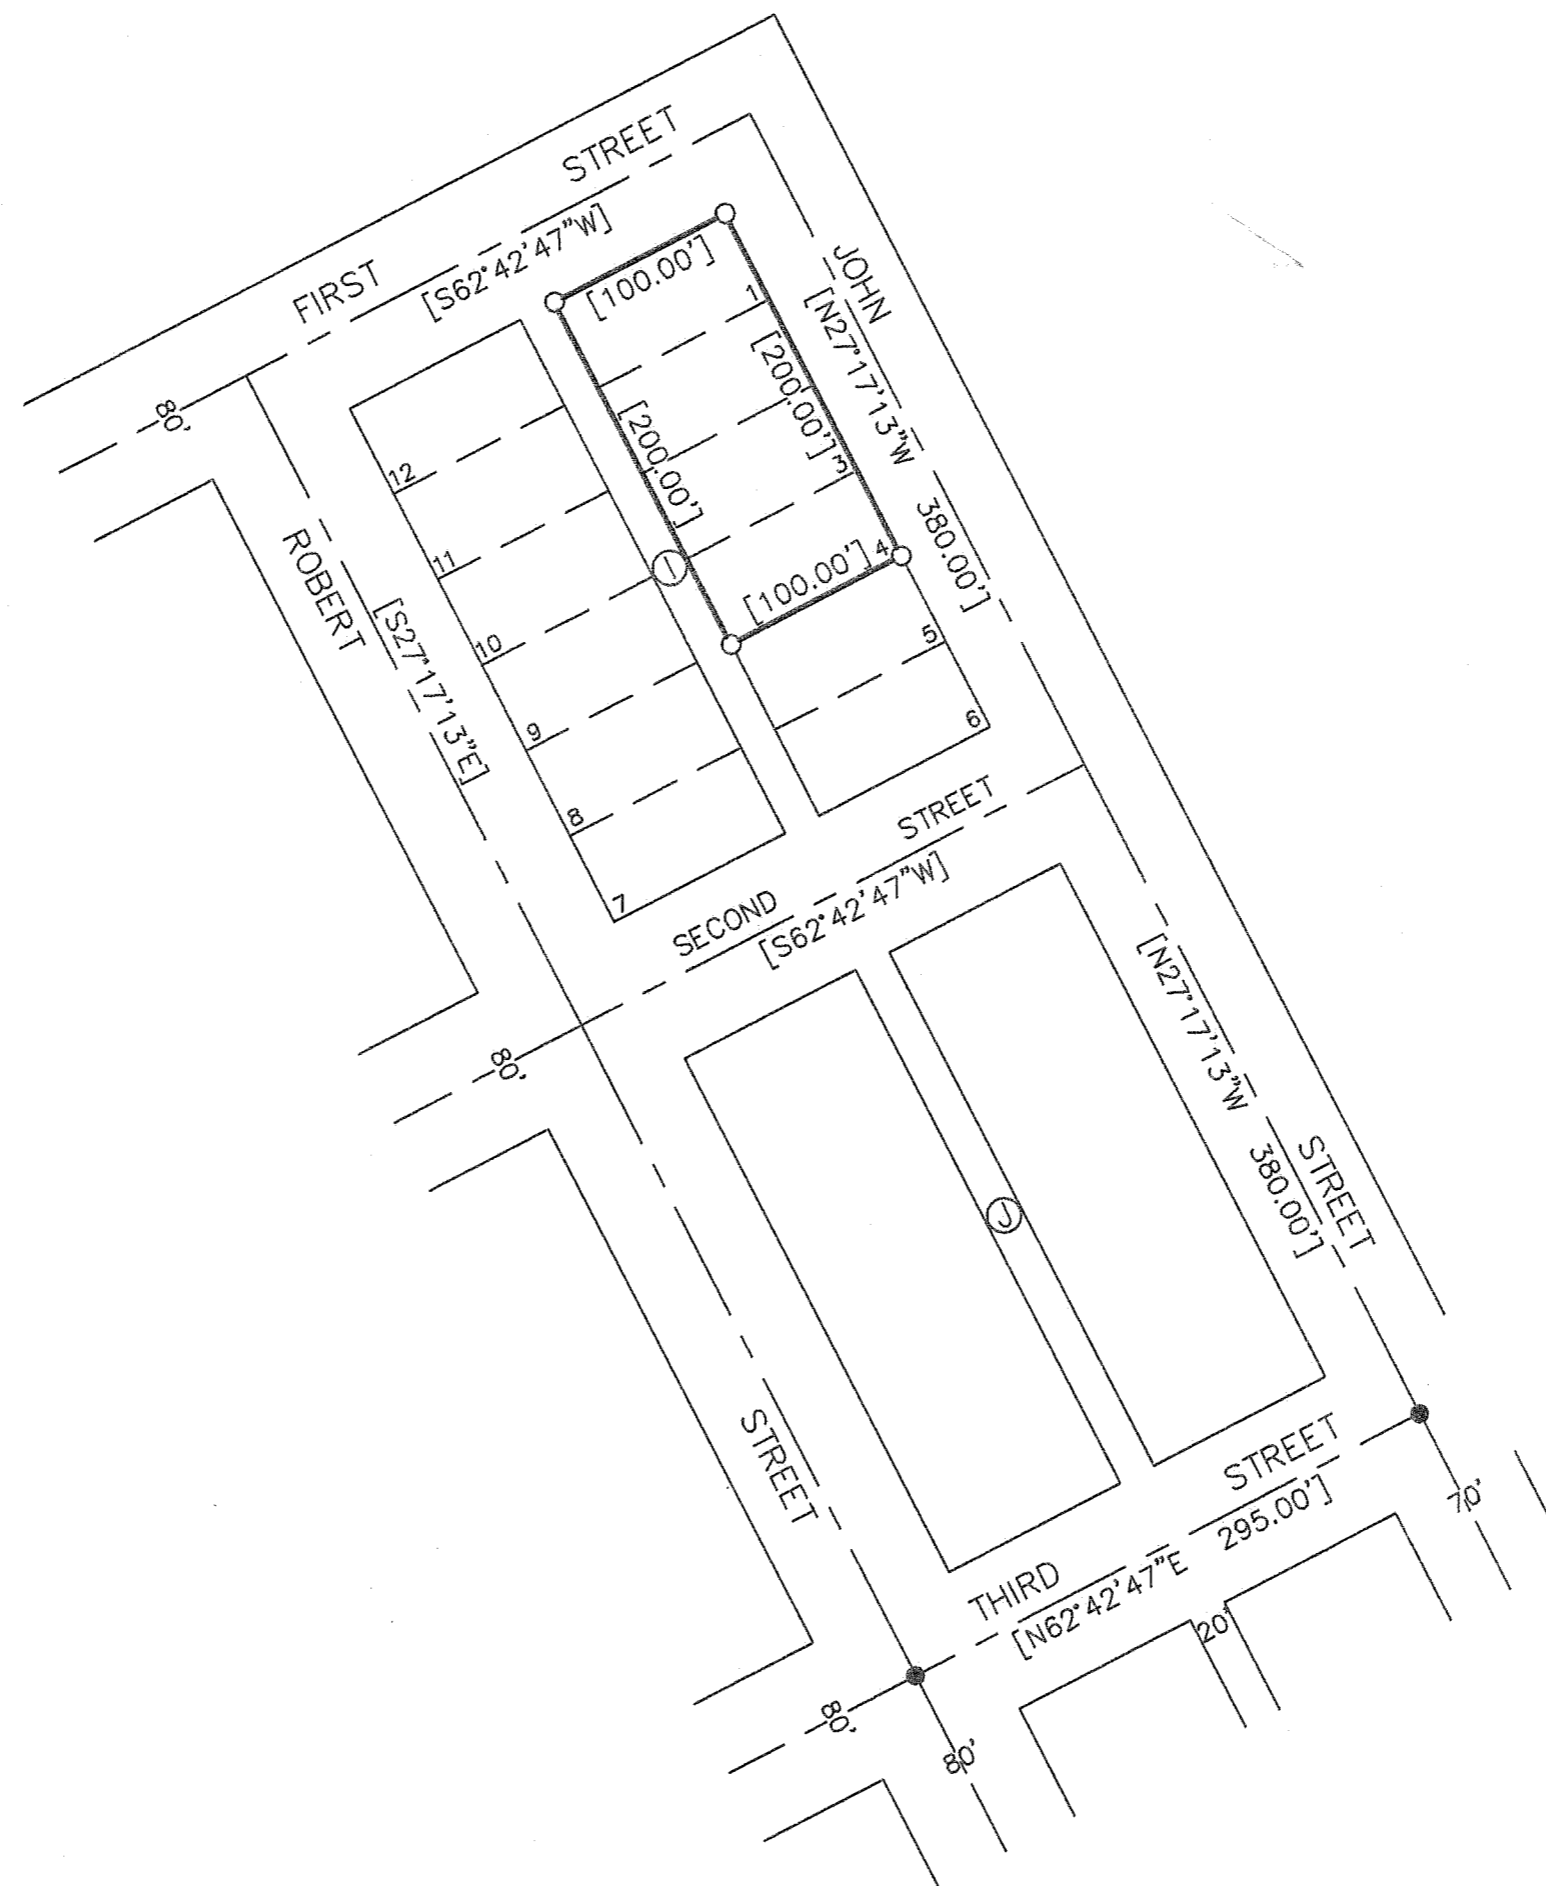

BASIS FOR BEARINGS
 Baker County Survey No. 7-39-36



LEGEND

- Found Monuments of Record ●
- Set 30" long No. 5 Rebar with Yellow Plastic Cap marked PLS 699 ○

FILED DECEMBER 17, 2004
 BAKER COUNTY SURVEYOR
 SURVEY No. 7-39-54