BETWEEN LANDS OF THE CITY OF HAINES AND AMANDA A. STEELE, TRUSTEE OF THE HENRY C. STEELE RESIDUAL TRUST, AND AMANDA A. STEELE, TRUSTEE OF TRUST B OF THE STEELE FAMILY TRUST, LOCATED IN THE NORTHEAST 1/4 AND IN THE SOUTHEAST 1/4 OF SECTION 34, T.75., R.39E., W.M.

BAKER COUNTY, OREGON FOUND I 1/2" ALUMINUM CAP ON I" IRON PIPE, MARKED AS SHOWN, SEE SURVEY -COUNTY ROAD NO. PLASTIC CAP IS MISSING N43°06'19"W 1087.27' (N42°04'34"W 1087.27')-COFFEY EXISTING CITY OF HAINES DOMESTIC SEWAGE LAGOONS APPROXIMATE SECTIONLINE BETWEEN SECTIONS 34 AND 35. SEE DETAIL A ON -(548°18'29"W 300.11')-542°43'26"E 299.99' (541°41'41"E 299.99') BASIS OF BEARINGS FROM SURVEY 7-39-11) THE EAST LINE OF THIS ADJUSTED BOUNDARY IS NOT INTENDED TO BE PARALLEL TO THE APPROXIMATE LOCATION OF EXISTING CITY OF HAINES THE SECTION LINE BETWEEN PARCEL SECTIONS 34 AND 35 SHOWN HERE. TAX LOT 7 39 34 #200: 42.60 ACRES BEFORE ADJUSTMENT (77.588 ACRES AFTER ADJUSTMENT) PLASTIC CAP IS MISSING 550°03'20"E 212.49' (549°01'35"E 212.49") **ADJUSTMENT AREA:** 524,080 SQ. FT. OR 34.988 ACRES N88°39'40"E 294.14' (N89°41'25"E 294.14') PLASTIC CAP IS MISSING PLASTIC CAP IS MISSING 544°53'50"E 430.62 -569°41'01"E 193.00 PLASTIC CAP IS MISSING (568°39'16"E 193.00') SURVEY NARRATIVE HENRY C. STEELE RESIDUAL TRUST AND

THIS SURVEY WAS PERFORMED AT THE REQUEST OF THE CITY OF HAINES, OREGON. THE CITY OF HAINES IS CONSTRUCTING IMPROVEMENTS TO THEIR MUNICIPAL SEWAGE DISPOSAL SYSTEM WHICH INCLUDE AN ADDITIONAL LAGOON CELL AND AN EXPANDED EFFLUENT IRRIGATION AREA. TO PROVIDE ADEQUATE LAND AREA FOR THESE IMPROVEMENTS, THE CITY IS SEEKING TO ENLARGE THEIR OWNERSHIP BY UTILIZING THE BOUNDARY ADJUSTMENT PROCESS.

THE EXISTING CITY PARCEL WAS CONVEYED TO THE CITY IN 1983 BY DEED 83 16 130 AND RECITES METES AND BOUNDS DIMENSIONS WHICH CORRESPOND WITH BAKER COUNTY SURVEY NO. 7-39-11. WE FIND ALL OF THE MONUMENTS PLACED BY SURVEY 7-39-11 AND DETERMINE THAT THEY ARE ACCEPTABLY LOCATED FOR THE PURPOSES OF THIS BOUNDARY ADJUSTMENT SURVEY. THE PROPERTY ADJOINING THE CITY PARCEL IS UNSURVEYED, COMPRISED OF IN EXCESS OF 300 ACRES, AND IS CURRENTLY IN THE OWNERSHIP OF THE HENRY C. STEELE RESIDUAL TRUST AND TRUST B OF THE STEELE FAMILY TRUST (SEE BAKER COUNTY DEED DOCUMENT NO. 02020022B). THE AREA OF ADJUSTMENT IS SHOWN IN A HATCH PATTERN FOR CLARITY.

TRUST B OF THE STEELE FAMILY TRUST PARCEL TAX LOT 7 39 34 *100: 332.05 ACRES BEFORE ADJUSTMENT (297.062 ACRES AFTER ADJUSTMENT)

REGISTERED **PROFESSIONAL** LAND SURVEYOR Mit B. Kul **OREGON** JAN. 20, 1998 MICHAEL B. POSADA

RENEWS 12/31/10


SURVEYOR'S CERTIFICATE

THIS MAP CORRECTLY REPRESENTS A SURVEY MADE BY ME OR UNDER MY DIRECTION AS DIRECTED BY THE CITY OF HAINES, OREGON, AND IN CONFORMANCE WITH THE REQUIREMENTS OF OREGON REVISED STATUTES.

FILED Sept. 10, 2009 BAKER COUNTY SURVEYOR SURVEY NO. 7-39-60

MICHAEL B. POSADA, P.L.S. 2849

09-09-09

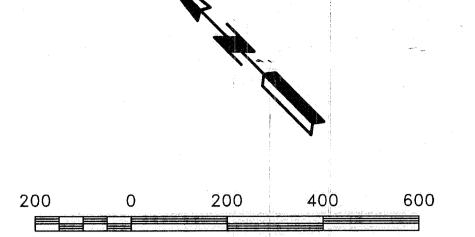

BASIS OF BEARINGS

SCALE: 1"=200'

BASIS OF BEARINGS IS 526°42'03"E ALONG THE REFERENCE LINE BETWEEN FOUND SURVEY MONUMENTS AS SHOWN HEREON. THIS BEARING IS REFERENCED TO GRID NORTH, OREGON COORDINATE SYSTEM-NORTH ZONE NAD83(96), AS DETERMINED BY A NATIONAL GEODETIC SURVEY "OPUS" SOLUTION OF STATIC GLOBAL POSITIONING SYSTEM OBSERVATIONS MADE AT THIS SITE. THE GRID-TRUE CONVERGENCE ANGLE AT THIS SITE IS 1°50'01" AND THE GROUND-GRID COMBINED SCALE FACTOR IS 0.9997419301 ALL DISTANCES SHOWN HEREON ARE AS MEASURED ON THE

REFERENCE MATERIAL

BAKER COUNTY SURVEYS:

7-39-11, 7-39-30, 7-39-46, 7-39-45MP, 7-39-58MP,

BAKER COUNTY CORNER REMONUMENTATION RECORDS: 7-39-6, 7-39-27, 7-39-29, 7-39-49, 7-40-2,

BAKER COUNTY DEED 83-16-130,

BAKER COUNTY DEED DOCUMENT 02020022B

GENERAL LAND OFFICE SURVEY, CONTRACT NO. 102, 1864, TIMOTHY DAVENPORT, DEPUTY SURVEYOR (SOUTH LINE OF T75, R39E),

GENERAL LAND OFFICE SURVEY, CONTRACT NO. 104, 1864, THOMPSON AND CHAPLIN, DEPUTY SURVEYORS, (SUBDIVISIONS OF

LEGEND

- 5/8" x 30" IRON ROD (REBAR) W/ I-I/2" ALUM. CAP INSCRIBED "APA WA 41295 OR 2849" TO BE SET, WHEN BOUNDARY ADJUSTMENT IS APPROVED BY BAKER COUNTY
- FOUND 5/8" IRON ROD WITH PLASTIC CAP MARKED "APA"-REFER TO BAKER COUNTY SURVEY NO. 7-39-11
- FOUND MONUMENT AS DESCRIBED
- (XXX.XX) RECORD DIMENSION PER BAKER COUNTY SURVEY NO. 7-39-11
- <XXX.XX> RECORD DIMENSION PER CITED DOCUMENT
- __ EXISTING FENCELINE
- ANCHOR
- ADJUSTMENT AREA-AMANDA A. STEELE, TRUSTEE, TO THE CITY OF HAINES, OREGON

FILE: Q:\HAINES\708-56-HAINES-WWTP\DWG\LAGOON-BDYADJUST\DWG

RECORD OF SURVEY PROPERTY LINE ADJUSTMENT

HENRY C. STEELE RESIDUAL TRUST AND TRUST B OF STEELE FAMILY TRUST. AMANDA A. STEELE, TRUSTEE-CITY OF HAINES, OREGON

FOR CITY OF HAINES, OREGON

SCALE

DATE:

JOB NO.

1" = 200'

SEPT., 2009

708-56 (080)

P.O. BOX 208 HAINES, OREGON 97833

LA GRANDE, OR. WALLA WALLA, WA.

SHEET

1901 N. FIR ST. LA GRANDE, OR 97850 (541) 963-8309