


**CERTIFIED RECORD OF LAND CORNER MONUMENTATION**

**HISTORY OF ORIGINAL CORNER ESTABLISHMENT:**

THIS CORNER WAS ORIGINALLY ESTABLISHED BY THOMPSON & CHAPLIN UNDER GLO CONTRACT NO. 104 DATED APRIL 16, 1864.

SURVEYOR GENERAL LAND OFFICE RECORDS STATE:  
"SET POST FOR 1/4 SECTION CORNER IN MOUND OF STONE"

**DIAGRAM**

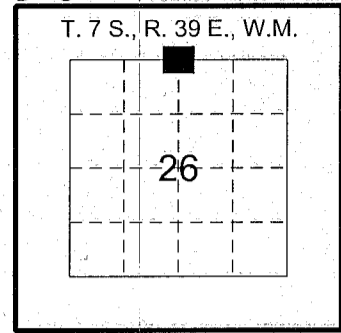

R-19

**DESCRIPTION OF CORNER EVIDENCE FOUND:**

FOUND A 30" DIAMETER MOUND OF STONES WITH T-POST LAYING NEARBY

**DESCRIPTION OF MONUMENT AND ACCESSORIES ESTABLISHED TO PERPETUATE THE ORIGINAL LOCATION OF THIS CORNER:**


RE-ESTABLISHED THE CORNER BY SETTING REPLACEMENT MONUMENT IN CENTER OF EXISTING STONE MOUND.

SET 3-1/4" ALUMINUM CAP ON A 5/8" X 30" IRON ROD.

THE CAP IS MARKED AS SHOWN BELOW.

THE REFERENCES SET FOR SAID CORNER ARE AS FOLLOWS:

- 1) A 5/8" X 30" IRON ROD WITH A 1-1/2" ALUMINUM CAP, STAMPED "ODOT" BEARS N26°24'37"W, 47.29 FEET.
- 2) A 5/8" X 30" IRON ROD WITH A 1-1/2" ALUMINUM CAP, STAMPED "ODOT" BEARS N48°52'55"E, 43.48 FEET.
- 3) A 5/8" X 30" IRON ROD WITH A 1-1/2" ALUMINUM CAP, STAMPED "ODOT" BEARS S58°05'39"E, 45.66 FEET.
- 4) A 5/8" X 30" IRON ROD WITH A 1-1/2" ALUMINUM CAP, STAMPED "ODOT" BEARS S57°33'30"W, 27.89 FEET.

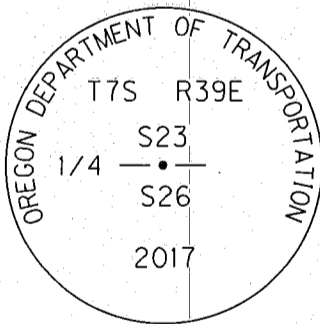

REGISTERED  
PROFESSIONAL  
LAND SURVEYOR

*BEC*

OREGON  
JAN 14, 2003  
BRET N. ELITHORP  
61348

RENEWS: 12/31/2017

WITNESSES:  
KEITH WOLFORD, LSI  
JOHN LINDER

I HEREBY CERTIFY THAT THE ABOVE CORNER POSITION WAS RE-ESTABLISHED AS HEREON DESCRIBED ON MAY 2, 2017.

OREGON DEPARTMENT OF TRANSPORTATION



FILED *May 25, 2017*

BAKER COUNTY SURVEYOR

SURVEY NO. *2-39-84*

Section	COYOTE POINT QUARRY		
Highway	COYOTE PEAK ROAD (CO. RD. 688)		
County	BAKER	Scale	NTS
Purpose	QUARRY BOUNDARY	Date	MAY 23, 2017