


CERTIFIED RECORD OF LAND CORNER MONUMENTATION

HISTORY OF ORIGINAL CORNER ESTABLISHMENT:
NONE

DIAGRAM

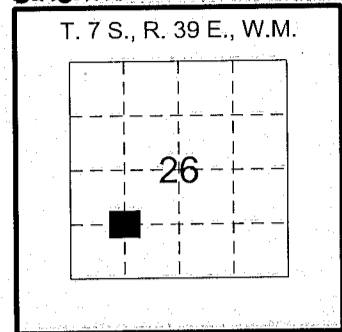

U-18

DESCRIPTION OF CORNER EVIDENCE FOUND:
NONE

DESCRIPTION OF MONUMENT AND ACCESSORIES I ESTABLISHED TO PERPETUATE THE ORIGINAL LOCATION OF THIS CORNER:


ESTABLISHED THE CORNER BY SINGLE PROPORTION AS SHOWN ON THE RECORD OF SURVEY FOR THE COYOTE POINT QUARRY BOUNDARY RESOLUTION FILED CONCURRENTLY WITH THIS CORNER MONUMENTATION RECORD.

SET 1-1/2" ALUMINUM CAP ON A 5/8" X 30" IRON ROD.

THE CAP IS MARKED AS SHOWN BELOW.

THE REFERENCES SET FOR SAID CORNER ARE AS FOLLOWS:

- 1) A 5/8" X 30" IRON ROD WITH A 1-1/2" ALUMINUM CAP, STAMPED "ODOT" BEARS N13°57'33"W, 49.88 FEET.
- 2) A 5/8" X 30" IRON ROD WITH A 1-1/2" ALUMINUM CAP, STAMPED "ODOT" BEARS N83°43'51"W, 42.71 FEET.

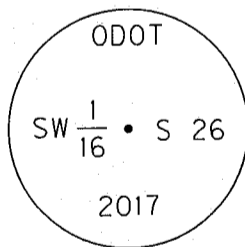

REGISTERED
PROFESSIONAL
LAND SURVEYOR

Bret N. Elithorp

OREGON
JAN 14, 2003
BRET N. ELITHORP
61348

RENEWS: 12/31/2017

WITNESSES:
KEITH WOLFORD, LSI
JOHN LINDER

I HEREBY CERTIFY THAT THE ABOVE CORNER POSITION WAS RE-ESTABLISHED AS HEREON DESCRIBED ON MAY 8, 2017.

OREGON DEPARTMENT OF TRANSPORTATION

**RIGHT OF WAY
ENGINEERING**

FILED *May 25, 2017*

BAKER COUNTY SURVEYOR

SURVEY NO. 7-39-88

Section	COYOTE POINT QUARRY		
Highway	COYOTE PEAK ROAD (CO. RD. 688)		
County	BAKER	Scale	NTS
Purpose	QUARRY BOUNDARY	Date	MAY 23, 2017