


CERTIFIED RECORD OF LAND CORNER MONUMENTATION

HISTORY OF ORIGINAL CORNER ESTABLISHMENT:

THIS CORNER WAS ORIGINALLY ESTABLISHED BY TIMOTHY W. DAVENPORT UNDER CONTRACT NO. 102 DATED JULY 20, 1863.

SURVEYOR GENERAL LAND OFFICE RECORDS STATE:
"SET POST CORNER TO SECTIONS 1, 2, 35 & 36.
MADE MOUND OF ROCK"

DIAGRAM

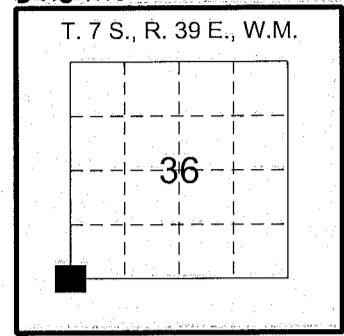

DESCRIPTION OF CORNER EVIDENCE FOUND:

FOUND A 45" DIAMETER MOUND OF ROCK AND REMNANTS OF AN OLD LATHE

DESCRIPTION OF MONUMENT AND ACCESSORIES I ESTABLISHED TO PERPETUATE THE ORIGINAL LOCATION OF THIS CORNER:


RE-ESTABLISHED THE CORNER BY SETTING REPLACEMENT MONUMENT IN CENTER OF EXISTING STONE MOUND.

SET 3-1/4" ALUMINUM CAP ON A 5/8" X 30" IRON ROD.

THE CAP IS MARKED AS SHOWN BELOW.

THE REFERENCES SET FOR SAID CORNER ARE AS FOLLOWS:

- 1) A 5/8" X 30" IRON ROD WITH A 1-1/2" ALUMINUM CAP, STAMPED "ODOT" BEARS N66°13'49"W, 43.69 FEET.
- 2) A 5/8" X 30" IRON ROD WITH A 1-1/2" ALUMINUM CAP, STAMPED "ODOT" BEARS N35°53'55"E, 46.70 FEET.
- 3) A 5/8" X 30" IRON ROD WITH A 1-1/2" ALUMINUM CAP, STAMPED "ODOT" BEARS S53°54'04"E, 42.43 FEET.
- 4) A 5/8" X 30" IRON ROD WITH A 1-1/2" ALUMINUM CAP, STAMPED "ODOT" BEARS S22°10'55"W, 42.33 FEET.

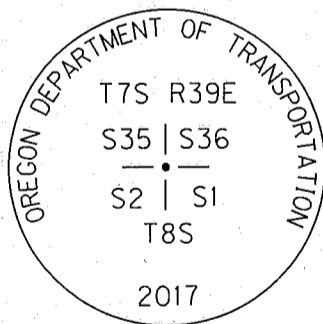

WITNESSES:
KEITH WOLFORD, LSI
JOHN LINDER

I HEREBY CERTIFY THAT THE ABOVE CORNER POSITION WAS RE-ESTABLISHED AS HEREON DESCRIBED ON MAY 3, 2017.

REGISTERED
PROFESSIONAL
LAND SURVEYOR

B. N. Elithorp

OREGON
JAN 14, 2003
BRET N. ELITHORP
61348

RENEWS: 12/31/2017

OREGON DEPARTMENT OF TRANSPORTATION



FILED May 25 2017

BAKER COUNTY SURVEYOR

SURVEY NO. 7-39-91

Section	COYOTE POINT QUARRY		
Highway	COYOTE PEAK ROAD (CO. RD. 688)		
County	BAKER	Scale	NTS
Purpose	QUARRY BOUNDARY	Date	MAY 23, 2017