

CERTIFIED RECORD OF LAND CORNER MONUMENTATION

HISTORY OF ORIGINAL CORNER ESTABLISHED:

Corner originally established by David P. Thompson and David Chaplin under GLO contract number 104 dated April 16, 1864. Surveyor General field notes state:

Set Stone 20x8x6 in. for 1/4 Sec. Corner

DESCRIPTION OF CORNER EVIDENCE FOUND:

Found fractured remnants of stone in an area otherwise devoid of stone. No marks found. Could not ascertain original size or position of stone.

DESCRIPTION OF MONUMENT AND ACCESSORIES I ESTABLISHED TO MONUMENT THE ORIGINAL LOCATION OF THIS CORNER:


At proportionate position, I set a 5/8"x30" iron pin, 27" in the ground, with 2 1/2" aluminum cap marked as shown below, in a collar of stone 2 ft. diam., from which:

NEW BEARING OBJECTS:


- A 5/8"x15" iron pin bears North, 20.00 feet with 1 1/2" aluminum cap marked BGB SURVEY MARKER N RP.
- A 5/8"x15" iron pin bears East, 20.00 feet with 1 1/2" aluminum cap marked BGB SURVEY MARKER E RP.
- A 5/8"x15" iron pin bears South, 20.00 feet with 1 1/2" aluminum cap marked BGB SURVEY MARKER S RP.
- A 5/8"x15" iron pin bears West, 20.00 feet with 1 1/2" aluminum cap marked BGB SURVEY MARKER W RP.

I hereby certify that the corner was monumented on October 31, 2019.

Set steel fence post approx. 1 ft. North.

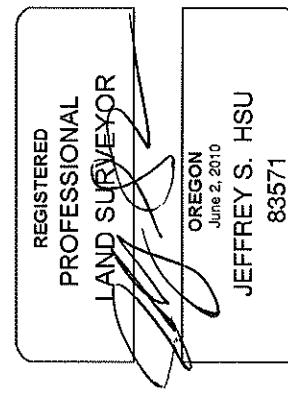

Renewal Date: June 30, 2021

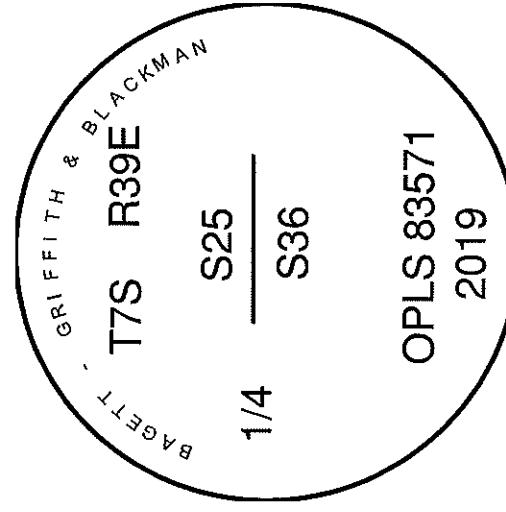

I used a Leica GS-18 RTK GPS in the establishment of the accessories. Bearings and distances are to the center of the aluminum caps. Basis of Bearings is as per Survey for McEst Ranches, as filed with the Baker County Surveyor.

V-23

FILED NOV. 6, 2019
BAKER COUNTY SURVEYOR
SURVEY NO. 1-39-94