

CERTIFIED RECORD OF LAND CORNER MONUMENTATION

**HISTORY OF ORIGINAL CORNER ESTABLISHED:**

Corner not previously established.

T 7 S R 39 E V-24

S	36	

**DESCRIPTION OF CORNER EVIDENCE FOUND:**

None.

**DESCRIPTION OF MONUMENT AND ACCESSORIES I ESTABLISHED TO MONUMENT THE ORIGINAL LOCATION OF THIS CORNER:**


At a position determined by survey, I set a 5/8"x30" iron pin, 26" in the ground, with 2 1/2" aluminum cap marked as shown below, from which:

**NEW BEARING OBJECTS:**

A 5/8"x15" iron pin bears North, a distance of 50.00 feet, with 1 1/2" aluminum cap marked BGB SURVEY MARKER N RP.  
A 5/8"x15" iron pin bears South, a distance of 20.00 feet, with 1 1/2" aluminum cap marked BGB SURVEY MARKER S RP.


I set a steel fence post approx. 0.5 feet N of monument.  
I hereby certify that the corner was monumented on October 31, 2019.

REGISTERED  
PROFESSIONAL  
LAND SURVEYOR



OREGON  
June 2, 2010  
JEFFREY S. HSU  
83571

Renewal Date: June 30, 2021

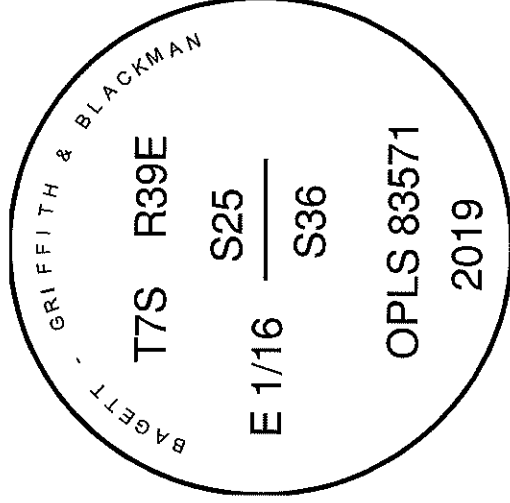

I used a Leica GS-18 RTK GPS in the establishment of the accessories. Bearings and distances are to the center of the aluminum caps. Basis of Bearings is as per Survey for McEst Ranches, as filed with the Baker County Surveyor.