


CERTIFIED RECORD OF LAND CORNER MONUMENTATION

HISTORY OF ORIGINAL CORNER ESTABLISHMENT:

THIS CORNER WAS ORIGINALLY ESTABLISHED BY THOMPSON & CHAPLIN UNDER GLO CONTRACT NO. 104 DATED APRIL 16, 1864.

SURVEYOR GENERAL LAND OFFICE RECORDS STATE:
"SET STONE 18"x12"x6" FOR 1/4 SECTION CORNER."

DIAGRAM

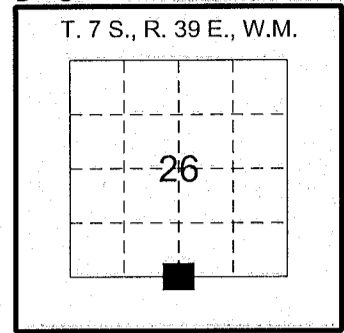

V-19

DESCRIPTION OF CORNER EVIDENCE FOUND:

FD 36" DIAMETER STONE MOUND W/ "T" POST NEARBY W/ TAG MARKED "T7S R39E 1/4 COR. 26, 35 LS2500"

DESCRIPTION OF MONUMENT AND ACCESSORIES I ESTABLISHED TO PERPETUATE THE ORIGINAL LOCATION OF THIS CORNER:


RE-ESTABLISHED THE CORNER BY SETTING REPLACEMENT MONUMENT IN CENTER OF EXISTING STONE MOUND.

SET 3-1/4" ALUMINUM CAP ON A 5/8" X 30" IRON ROD.

THE CAP IS MARKED AS SHOWN BELOW.

THE REFERENCES SET FOR SAID CORNER ARE AS FOLLOWS:

- 1) A 5/8" X 30" IRON ROD WITH A 1-1/2" ALUMINUM CAP, STAMPED "ODOT" BEARS N60°52'01"W, 46.40 FEET.
- 2) A 5/8" X 30" IRON ROD WITH A 1-1/2" ALUMINUM CAP, STAMPED "ODOT" BEARS N37°17'20"E, 40.54 FEET.
- 3) A 5/8" X 30" IRON ROD WITH A 1-1/2" ALUMINUM CAP, STAMPED "ODOT" BEARS S50°14'03"E, 43.20 FEET.
- 4) A 5/8" X 30" IRON ROD WITH A 1-1/2" ALUMINUM CAP, STAMPED "ODOT" BEARS S32°13'13"W, 49.43 FEET.

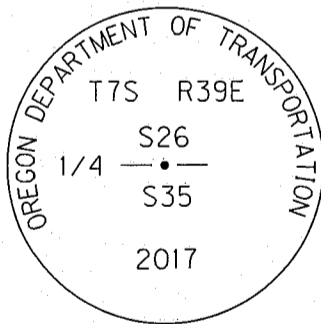

WITNESSES:
KEITH WOLFORD, LSI
JOHN LINDER

I HEREBY CERTIFY THAT THE ABOVE CORNER POSITION WAS RE-ESTABLISHED AS HEREON DESCRIBED ON MAY 9, 2017.

REGISTERED
PROFESSIONAL
LAND SURVEYOR

Bret N. Elithorp

OREGON
JAN 14, 2003
BRET N. ELITHORP
61348

RENEWS: 12/31/2017

OREGON DEPARTMENT OF TRANSPORTATION



**RIGHT OF WAY
ENGINEERING**

FILED *May 25, 2017*

BAKER COUNTY SURVEYOR

SURVEY NO. 7-39-89

Section	COYOTE POINT QUARRY		
Highway	COYOTE PEAK ROAD (CO. RD. 688)		
County	BAKER	Scale	NTS
Purpose	QUARRY BOUNDARY	Date	MAY 23, 2017