


CERTIFIED RECORD OF LAND CORNER MONUMENTATION

HISTORY OF ORIGINAL CORNER ESTABLISHMENT:

THIS CORNER WAS ORIGINALLY ESTABLISHED BY THOMPSON & CHAPLIN UNDER GLO CONTRACT NO. 104 DATED APRIL 16, 1864.

SURVEYOR GENERAL LAND OFFICE RECORDS STATE:
"SET STONE 18"X10"X8" FOR THE CORNER TO SECTIONS 25, 26, 35 & 36."

DIAGRAM

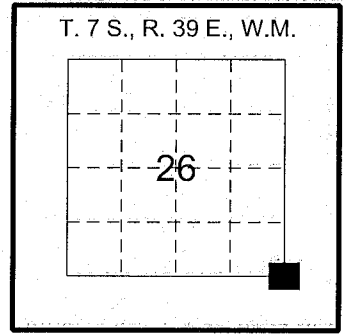

V-21

DESCRIPTION OF CORNER EVIDENCE FOUND:

NONE


DESCRIPTION OF MONUMENT AND ACCESSORIES I ESTABLISHED TO PERPETUATE THE ORIGINAL LOCATION OF THIS CORNER:

RE-ESTABLISHED CORNER BY DOUBLE PROPORTION AS SHOWN ON THE RECORD OF SURVEY FOR THE COYOTE POINT QUARRY BOUNDARY RESOLUTION FILED CONCURRENTLY WITH THIS CORNER MONUMENTATION RECORD.

SET 5/8"X30" IRON ROD WITH 3-1/4" ALUMINUM CAP MARKED AS SHOWN BELOW.

THE REFERENCES SET FOR SAID CORNER ARE AS FOLLOWS:

- 1) A 5/8" X 30" IRON ROD WITH A 1-1/2" ALUMINUM CAP, STAMPED "ODOT" BEARS N51°19'24"W, 46.87 FEET.
- 2) A 5/8" X 30" IRON ROD WITH A 1-1/2" ALUMINUM CAP, STAMPED "ODOT" BEARS N29°33'47"E, 39.91 FEET.
- 3) A 5/8" X 30" IRON ROD WITH A 1-1/2" ALUMINUM CAP, STAMPED "ODOT" BEARS S49°36'35"E, 37.32 FEET.
- 4) A 5/8" X 30" IRON ROD WITH A 1-1/2" ALUMINUM CAP, STAMPED "ODOT" BEARS S25°26'24"W, 48.18 FEET.

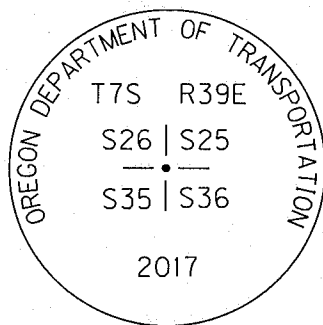

WITNESSES:
KEITH WOLFORD, LSI
JOHN LINDER

I HEREBY CERTIFY THAT THE ABOVE CORNER POSITION WAS RE-ESTABLISHED AS HEREON DESCRIBED ON MAY 2, 2017.

REGISTERED
PROFESSIONAL
LAND SURVEYOR

Bret N. Elithorp

OREGON
JAN 14, 2003
BRET N. ELITHORP
61348

RENEWS: 12/31/2017

OREGON DEPARTMENT OF TRANSPORTATION



**RIGHT OF WAY
ENGINEERING**

FILED *May 25, 2017*

BAKER COUNTY SURVEYOR

SURVEY NO. 7-39-90

Section	COYOTE POINT QUARRY		
Highway	COYOTE PEAK ROAD (CO. RD. 688)		
County	BAKER	Scale	NTS
Purpose	QUARRY BOUNDARY	Date	MAY 23, 2017