


**CERTIFIED RECORD OF LAND CORNER MONUMENTATION**

**HISTORY OF ORIGINAL CORNER ESTABLISHED:**

Corner originally established by David Thompson and Daniel Chaplin under GLO Contract Number 104, dated April 16th, 1864. Surveyor General Field Notes state:

Set post for 1/4 sec. cor. in mound of earth with charred stake, pits, trench, as per instructions.

T 7 S R 39 E G-17

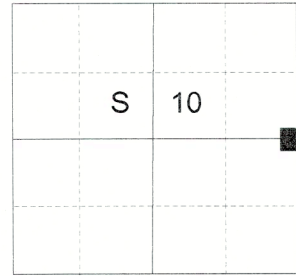

**DESCRIPTION OF CORNER EVIDENCE FOUND:**


Found fence corner from which fences bears North, East and West that are harmonious in distance to the rock jack fence corner to the North, accepted as the Section corner in Surveys 7-39-2 and 7-39-20.

**DESCRIPTION OF MONUMENT AND ACCESSORIES I ESTABLISHED TO MONUMENT THE ORIGINAL LOCATION OF THIS CORNER:**

At found fence corner, I set a 2 1/2" x 30" aluminum pipe, 26" in the ground, with 3" aluminum cap marked as shown below and in a 2 foot diameter collar of stone, from which:

**NEW BEARING OBJECTS:**

- A 5/8" x 15" iron pin bears North 3°28' East, a distance of 26.03 feet with 1 1/2" aluminum cap marked NE RP BGB SURVEY MARKER.
- A 5/8" x 15" iron pin bears South 43°08' East, a distance of 13.92 feet with 1 1/2" aluminum cap marked SE RP BGB SURVEY MARKER.
- A 5/8" x 15" iron pin bears South 48°46' West, a distance of 12.28 feet with 1 1/2" aluminum cap marked SW RP BGB SURVEY MARKER.
- A 5/8" x 15" iron pin bears North 82°33' West, a distance of 17.06 feet with 1 1/2" aluminum cap marked NW RP BGB SURVEY MARKER.

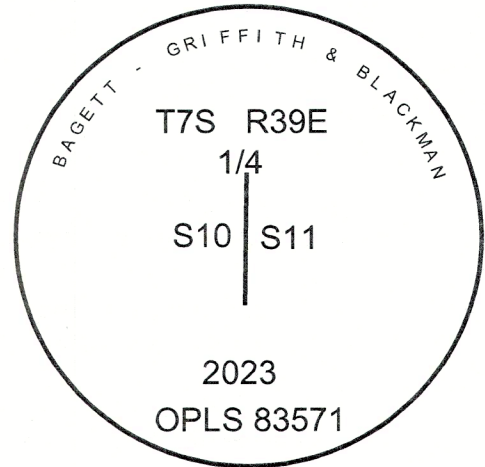

I hereby certify that the corner was monumented on June 2, 2023.

Witness: Kyle Tucker



Renewal Date: June 30, 2025

I used a Leica GS18 with RTK in the establishment of the new accessories. Bearings and distances are measured to the center of the aluminum caps. Basis of bearing is as per Survey for Brad Allen, filed concurrently.

**FILED** July 19, 2023  
BAKER COUNTY SURVEYOR  
SURVEY NO. 7-39-110