

CERTIFIED RECORD OF LAND CORNER MONUMENTATION

**HISTORY OF ORIGINAL CORNER ESTABLISHED:**

Corner originally established by David Thompson and Daniel Chaplin under GLO Contract Number 104, dated April 16th, 1864. Surveyor General Field Notes state:

Set post for cor. to secs. 9, 10, 15, & 16 in mound of earth with charred stake, pits, trench, as per instructions.

ODOT strip map 5B-11-23 shows a tie to the corner. No description given.

T 7 S R 39 E J-13

	S 16	

**DESCRIPTION OF CORNER EVIDENCE FOUND:**

None. Falls in a cultivated field.

**DESCRIPTION OF MONUMENT AND ACCESSORIES I ESTABLISHED TO MONUMENT THE ORIGINAL LOCATION OF THIS CORNER:**

At position as per ODOT strip map, I set a 5/8" x 30" iron pin, 60" in the ground, with 2 1/2" aluminum cap marked as shown below, from which:


**NEW BEARING OBJECTS:**

A 5/8" x 30" iron pin bears North 51°28' East, a distance of 26.66 feet with 1 1/2" aluminum cap marked N RP BGB SURVEY MARKER.

A 5/8" x 30" iron pin bears South 45°20' East, a distance of 21.41 feet marked SE RP BGB SURVEY MARKER.

A 4" irrigation stand pipe bears South 57°06' West, a distance of 104.16 feet marked "X" on top bolt.

A 5/8" x 30" iron pin bears North 33°18' West, a distance of 70.40 feet marked ODOT.

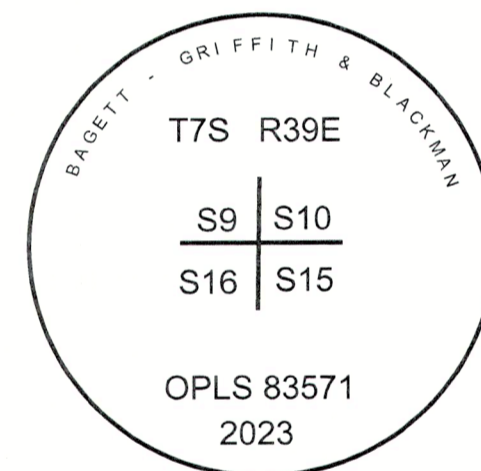

I hereby certify that the corner was monumented on May 26, 2023.

Witness: Kyle Tucker



Renewal Date: June 30, 2025

I used a Leica GS18 with RTK in the establishment of the new accessories. Bearings and distances are measured to the center of the aluminum caps/or the "X" on the bolt. Basis of bearing is as per Survey, filed concurrently.

J-13

FILED July 19, 2023  
BAKER COUNTY SURVEYOR  
SURVEY NO. 7-39-111