


**CERTIFIED RECORD OF LAND CORNER MONUMENTATION**

**HISTORY OF ORIGINAL CORNER ESTABLISHED:**

Corner originally established by David Thompson and Daniel Chaplin under GLO Contract Number 104, dated April 16th, 1864. Surveyor General Field Notes state:

Set post for cor. to secs. 10, 11, 14, + 15, in mound of earth with charred stake, pits, trench, as per instructions.

T 7 S R 39 E J-17

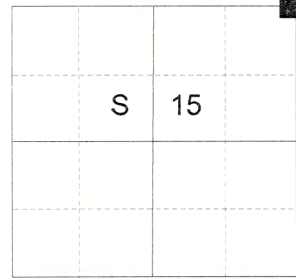

**DESCRIPTION OF CORNER EVIDENCE FOUND:**

None.

**DESCRIPTION OF MONUMENT AND ACCESSORIES I ESTABLISHED TO MONUMENT THE ORIGINAL LOCATION OF THIS CORNER:**


At proportionate position, I set a 5/8" x 30" iron pin, 30" drilled into the ground, with 2 1/2" aluminum cap marked as shown below, and flush with the road surface of a North/South powerline maintenance road, from which:

**NEW BEARING OBJECTS:**

- A 5/8" x 30" iron pin bears North 39°10' East, a distance of 19.40 feet with 1 1/2" aluminum cap marked NE RP BGB SURVEY MARKER.
- A 5/8" x 30" iron pin bears South 40°11' East, a distance of 19.35 feet with 1 1/2" aluminum cap marked SE RP BGB SURVEY MARKER.
- A 5/8" x 30" iron pin bears South 51°29' West, a distance of 26.35 feet with 1 1/2" aluminum cap marked SW RP BGB SURVEY MARKER.
- A 5/8" x 30" iron pin bears North 52°45' West, a distance of 44.84 feet with 1 1/2" aluminum cap marked NW RP BGB SURVEY MARKER.

Set steel fence post approx. 5 feet East on edge of road.

I hereby certify that the corner was monumented on June 8, 2023.  
Witness: Kyle Tucker

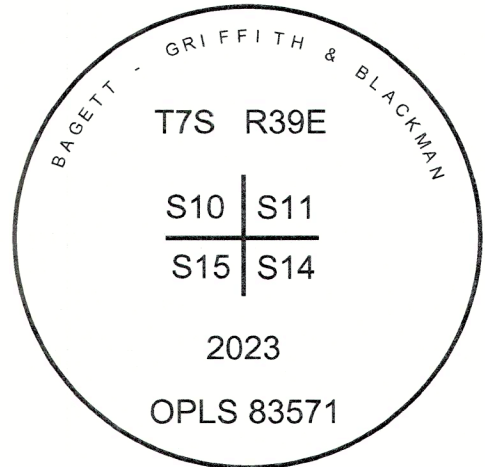

Renewal Date: June 30, 2025

I used a Leica GS18 with RTK in the establishment of the new accessories. Bearings and distances are measured to the center of the aluminum caps. Basis of bearing is as per Survey filed concurrently.

J-17

FILED July 19, 2023  
BAKER COUNTY SURVEYOR  
SURVEY NO. 7-39-113