


CERTIFIED RECORD OF LAND CORNER MONUMENTATION

HISTORY OF ORIGINAL CORNER ESTABLISHED:

Corner originally established by David Thompson and Daniel Chaplin under GLO Contract Number 104, dated April 16th, 1864. Surveyor General Field Notes state:

Set post for 1/4 sec. cor. in mound of earth with charred stake, pits, trench, as per instructions.

T 7 S R 39 E J-19

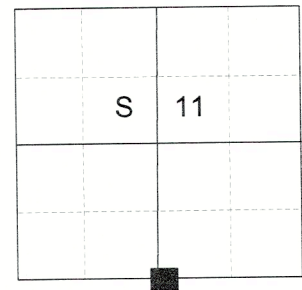

DESCRIPTION OF CORNER EVIDENCE FOUND:

None.

DESCRIPTION OF MONUMENT AND ACCESSORIES I ESTABLISHED TO MONUMENT THE ORIGINAL LOCATION OF THIS CORNER:

At proportionate position, I set a 5/8" x 30" iron pin, 30" in the ground, with 2 1/2" aluminum cap marked as shown below, from which:


NEW BEARING OBJECTS:

A 5/8" x 15" iron pin bears North, a distance of 20.00 feet with 1 1/2" aluminum cap marked N RP BGB SURVEY MARKER.

A 5/8" x 15" iron pin bears East, a distance of 20.00 feet with 1 1/2" aluminum cap marked E RP BGB SURVEY MARKER.

A 5/8" x 15" iron pin bears South, a distance of 20.00 feet with 1 1/2" aluminum cap marked S RP BGB SURVEY MARKER.

A 5/8" x 15" iron pin bears West, a distance of 20.10 feet with 1 1/2" aluminum cap marked W RP BGB SURVEY MARKER.

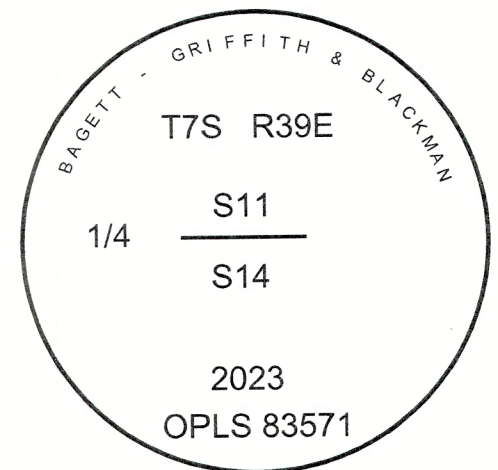

I hereby certify that the corner was monumented on June 20, 2023.



Renewal Date: June 30, 2025

I used a Leica GS18 with RTK in the establishment of the new accessories. Bearings and distances are measured to the center of the aluminum caps. Basis of bearing is as per Survey for Brad Allen, filed concurrently.

J-19

FILED July 19, 2023
BAKER COUNTY SURVEYOR
SURVEY NO. 7-39-114