

CERTIFIED RECORD OF LAND CORNER MONUMENTATION

HISTORY OF ORIGINAL CORNER ESTABLISHED:


Corner originally established by David Thompson and Daniel Chaplin under GLO Contract Number 104, dated April 16th, 1864. Surveyor General Field Notes state:

Set post for cor. to secs. 11, 12, 13, + 14, in mound of earth with charred stake, pits, trench, as per instructions.

In 1984, as shown on Survey 7-39-32, James Hanley accepts an ancient rock jack

In 2001, as shown on Survey 7-39-47, Gregory Blackman also accepts the old rock jack fence corner

T 7 S R 39 E J-21

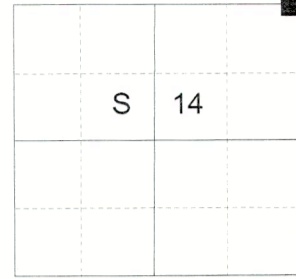

DESCRIPTION OF CORNER EVIDENCE FOUND:

At a position determined by retracing Survey 7-39-47, I find the remains of a large rock jack. Upon excavation I find a perfectly preserved tapered and charred 3" x 3" x 12" hand tapered wooden stake approx. 8" under water at the Northwest corner of the rock jack. Other timbers comprising the rock jack have saw cut ends.

DESCRIPTION OF MONUMENT AND ACCESSORIES I ESTABLISHED TO MONUMENT THE ORIGINAL LOCATION OF THIS CORNER:


At position of found tapered wooden stake, I set a 2 1/2" x 30" aluminum pipe, 20" in the ground and 2" above the current water level, with 3" aluminum cap marked as shown below and in a 3 foot diameter mound of stone from base to top of cap, from which:

NEW BEARING OBJECTS:

- A 5/8" x 30" iron pin bears North 33°24' East, a distance of 29.33 feet with 1 1/2" aluminum cap marked NE RP BGB SURVEY MARKER.
- A 5/8" x 30" iron pin bears South 38°14' East, a distance of 30.54 feet with 1 1/2" aluminum cap marked SE RP BGB SURVEY MARKER.
- A 5/8" x 30" iron pin bears South 53°24' West, a distance of 33.19 feet with 1 1/2" aluminum cap marked SW RP BGB SURVEY MARKER.
- A 5/8" x 30" iron pin bears North 47°19' West, a distance of 29.47 feet with 1 1/2" aluminum cap marked NW RP BGB SURVEY MARKER.

Mound of stone remains of a rock jack now 6 foot diam. x 3 foot tall bears 4 feet Southeasterly

I hereby certify that the corner was monumented on June 8, 2023.
Witness: Kyle Tucker

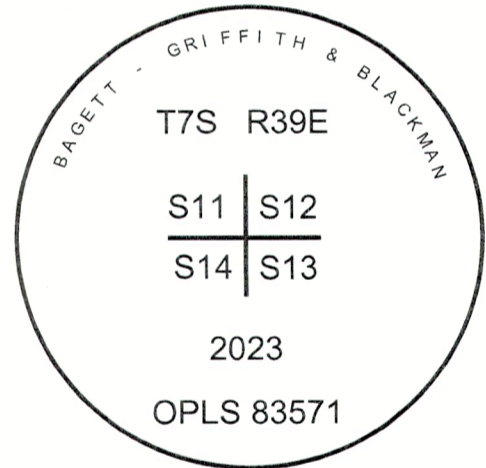

Renewal Date: June 30, 2025

I used a Leica GS18 with RTK in the establishment of the new accessories. Bearings and distances are measured to the center of the aluminum caps. Basis of bearing is as per Survey filed concurrently.

J-21

FILED July 19, 2023
BAKER COUNTY SURVEYOR
SURVEY NO. 7-39-115