


CERTIFIED RECORD OF LAND CORNER MONUMENTATION

**HISTORY OF ORIGINAL CORNER ESTABLISHED:**

Corner not previously established

T 7 S R 39 E K-21

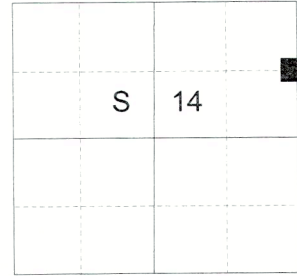

**DESCRIPTION OF CORNER EVIDENCE FOUND:**

None

**DESCRIPTION OF MONUMENT AND ACCESSORIES I ESTABLISHED TO MONUMENT THE ORIGINAL LOCATION OF THIS CORNER:**

At position by Survey, I set a 5/8" x 30" iron pin, 27" in the ground, with 2 1/2" aluminum cap marked as shown below in a 2 foot collar of stone, from which:

**NEW BEARING OBJECTS:**

A powerpole bears South 49°07' East, a distance of 20.84 feet with 60D nail in the right side 0.5 feet above ground.


A 5/8" iron pin bears North 0°08' West, a distance of 16.15 feet with yellow plastic cap marked BGB SURVEY MARKER and set by Survey 7-39-47.

Set steel fence post approx. 0.5 feet South.

Falls approx. 8 feet South and 8 feet West of fence corner to North/East/West bearing fence lines.

I hereby certify that the corner was monumented on June 8, 2023.

Witness: Kyle Tucker

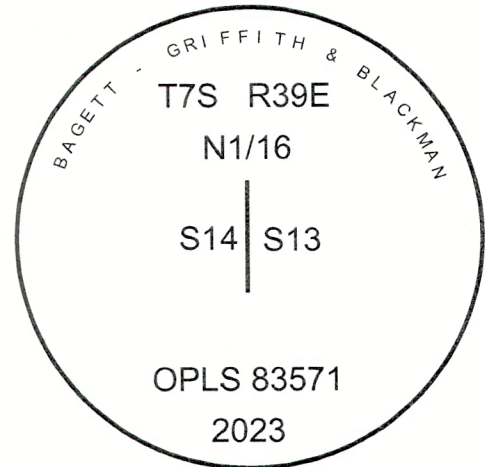

I used a Leica GS18 with RTK in the establishment of the new accessories. Bearings and distances are measured to the center of the caps or the center of power pole. Distance to the power pole is to the spike. Basis of bearing is as per Survey filed concurrently.



Renewal Date: June 30, 2025

K-21

FILED July 19, 2023  
BAKER COUNTY SURVEYOR  
SURVEY NO. 7-39-119