

CERTIFIED RECORD OF LAND CORNER MONUMENTATION


HISTORY OF ORIGINAL CORNER ESTABLISHED:

Corner originally established by David Thompson and Daniel Chaplin under GLO Contract Number 104, dated April 16th, 1864. Surveyor General Field Notes state:

Set post for 1/4 sec. cor. in mound of earth with charred stake, pits, trench, as per instructions.

Corner is noted on ODOT strip map 5B-11-23. No description given.

T 7 S R 39 E L-13

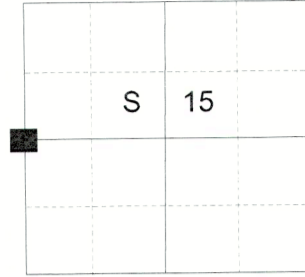

DESCRIPTION OF CORNER EVIDENCE FOUND:

Found 2 stones well planted and extending 6" above ground. The Westerly stone is 4"x8" exposed and the Easterly stone is 2"x5" exposed and marked 1/4 on East. I do not fully excavate said stones.

The stones fall within 3 feet of surveyed position using the highway alignment from the Haines Highway as shown on said ODOT strip map. I accept them as a perpetuation of the original corner monument.

DESCRIPTION OF MONUMENT AND ACCESSORIES I ESTABLISHED TO MONUMENT THE ORIGINAL LOCATION OF THIS CORNER:

At center of stones position, I set a 5/8" x 30" iron pin between them, 24" in the ground, with 2 1/2" aluminum cap marked as shown below, from which:

NEW BEARING OBJECTS:

A 5/8" x 30" iron pin bears North 45°59' East, a distance of 25.59 feet with 1 1/2" aluminum cap marked NE RP BGB SURVEY MARKER.


A 5/8" x 30" iron pin bears South 33°42' East, a distance of 22.40 feet with 1 1/2" aluminum cap marked SE RP BGB SURVEY MARKER.

A 5/8" x 30" iron pin bears South 36°29' West, a distance of 27.60 feet with 1 1/2" aluminum cap marked SW RP BGB SURVEY MARKER.

A 5/8" x 30" iron pin bears North 53°28' West, a distance of 11.82 feet with 1 1/2" aluminum cap marked NW RP BGB SURVEY MARKER.

An East/West fence line bears approx. 18 feet North and remnants of a North/South fence bears approx 7 feet West

I hereby certify that the corner was monumented on May 26, 2023.
Witness: Kyle Tucker

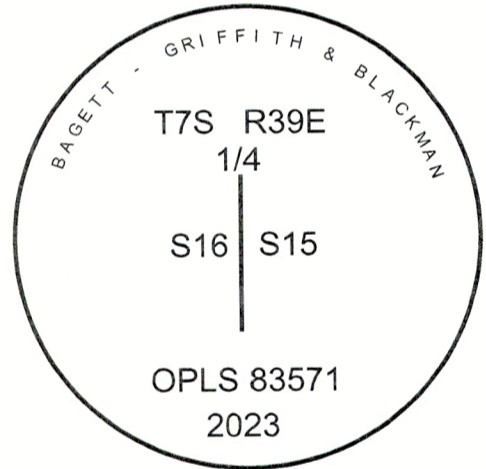

I used a Leica GS18 with RTK in the establishment of the new accessories. Bearings and distances are measured to the center of the aluminum caps. Basis of bearing is as per Survey filed concurrently in Baker County.

L-13

FILED July 19, 2023
BAKER COUNTY SURVEYOR
SURVEY NO. 2-39-120