

CERTIFIED RECORD OF LAND CORNER MONUMENTATION

HISTORY OF ORIGINAL CORNER ESTABLISHED:

Corner originally established by David Thompson and Daniel Chaplin under GLO Contract Number 104, dated April 16th, 1864. Surveyor General Field Notes state:

Set post for 1/4 sec. cor. in mound of earth with charred stake, pits, trench, as per instructions.

In 2001, Gregory Blackman, in the course of Survey Number 7-39-47, sets an aluminum pipe by retracement of County Road. Baker County Monumentation record 7-39-48 states:

At position established by survey, I set a 2 1/2" x 30" aluminum monument, marked as shown below, 38" in the ground, from which:

A power Pole bears N 51° E, 67.75 feet, with a 60d spike 1.0' from ground on the East side of pole.

A power Pole bears S 51° E, 75.05 feet, with a 60d spike 1.0' from ground on the South side of pole.

A power Pole bears S 46° W, 68.55 feet, with a 60d spike 1.0' from ground on the East side of pole.

An irrigation riser bears S 83° W, 48.33 feet, (no bearing object available in NW quadrant)

Set steel fence post 1 ft. South of Monument

DESCRIPTION OF CORNER EVIDENCE FOUND:

Found telephone pole references in good shape. Monument was found uprooted and approx. 100 feet West of true point. The irrigation riser at South 83° West has been removed.

DESCRIPTION OF MONUMENT AND ACCESSORIES I ESTABLISHED TO MONUMENT THE ORIGINAL LOCATION OF THIS CORNER:

At position determined by found references, I reset the 2 1/2" x 30" aluminum pipe, 28" in the ground, with 2 1/2" aluminum cap marked as shown below and a 2 foot diameter collar of stone, from which:

NEW BEARING OBJECTS:

A 4" irrigation riser bears North 41°15' East, a distance of 91.72 feet marked "X" on top of center bolt.


Set steel fence post approx. 1 foot North.

Falls North of Haines Dump Road

I hereby certify that the corner was monumented on May 23, 2023.


Witness: Kyle Tucker

T 7 S R 39 E L-21

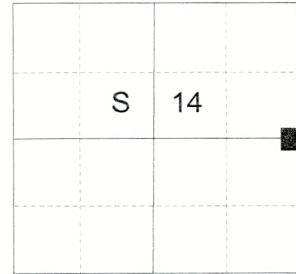

Renewal Date: June 30, 2025

I used a Leica GS18 with RTK in the establishment of the new accessories. Bearings are measured to the center of the riser bolt or center of telephone pole and distances are measured to the center of the bolt or nail. Basis of bearing is as per Survey, filed concurrently.

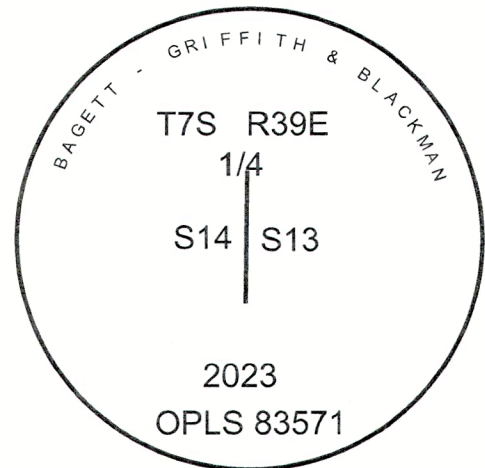

FILED July 19, 2023
BAKER COUNTY SURVEYOR
SURVEY NO. 7-39-123