

**CERTIFIED RECORD OF LAND CORNER MONUMENTATION**


**HISTORY OF ORIGINAL CORNER ESTABLISHED:**

Corner originally established by David Thompson and Daniel Chaplin under GLO Contract Number 104, dated April 16th, 1864. Surveyor General Field Notes state:

Set post for cor. to secs. 15, 16, 21, 22, in mound of earth with charred stake, pits, trench, as per instructions.

In 1919 Ira Hoffman finds a stone. Book 34, Page 6 of the Hoffman notes states: cor. to secs 15, 22, 16, + 21 T7S R39E A stone 12 x 10 x 3 1/2 feet above ground.

T 7 S R 39 E N-13

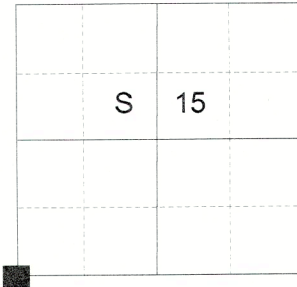

**DESCRIPTION OF CORNER EVIDENCE FOUND:**


Found 12" x 10" x 48" stone lying Westerly and marked with a 22, 21, and 15 on their respective sides. I did not excavate the bottom.

**DESCRIPTION OF MONUMENT AND ACCESSORIES I ESTABLISHED TO MONUMENT THE ORIGINAL LOCATION OF THIS CORNER:**

At base of fallen stone, I set a 2 1/2" x 30" aluminum pipe, 27" in the ground, with 3" aluminum cap marked as shown below, from which:

**NEW BEARING OBJECTS:**

- A 5/8" x 30" iron pin bears North 67°18' East, a distance of 20.60 feet with 1 1/2" aluminum cap marked NE RP BGB SURVEY MARKER.
- A 5/8" x 30" iron pin bears South 18°53' East, a distance of 20.41 feet with 1 1/2" aluminum cap marked SE RP BGB SURVEY MARKER.
- A 5/8" x 30" iron pin bears South 56°50' West, a distance of 19.18 feet with 1 1/2" aluminum cap marked SW RP BGB SURVEY MARKER.
- A 5/8" x 30" iron pin bears North 38°17' West, a distance of 18.20 feet with 1 1/2" aluminum cap marked NW RP BGB SURVEY MARKER.

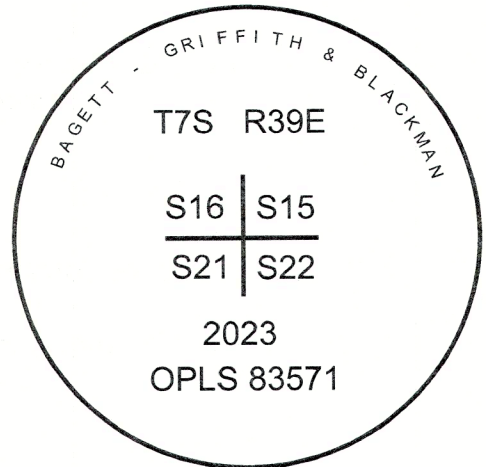

Set steel fence post approx. 0.5 feet East

Falls in pasture within 25 feet of an irrigation ditch

I hereby certify that the corner was monumented on May 26, 2023.  
Witness: Kyle Tucker



Renewal Date: June 30, 2025

I used a Leica GS18 with RTK in the establishment of the new accessories. Bearings and distances are measured to the center of the aluminum caps. Basis of bearing is as per Survey filed concurrently.

N-13

FILED July 19, 2023  
BAKER COUNTY SURVEYOR  
SURVEY NO. 7-39-124