


CERTIFIED RECORD OF LAND CORNER MONUMENTATION

HISTORY OF ORIGINAL CORNER ESTABLISHED:

Corner originally established by David Thompson and Daniel Chaplin under GLO Contract Number 104, dated April 16th, 1864. Surveyor General Field Notes state:

Set post for 1/4 sec. cor. in mound of earth with charred stake, pits, trench, as per instructions.

T 7 S R 39 E N-15

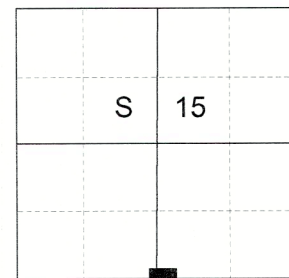

DESCRIPTION OF CORNER EVIDENCE FOUND:


Found an 8" x 3" x 42" stone, no markings, with 1/2" x 30" iron pin on the North edge in a pasture devoid of stone.

DESCRIPTION OF MONUMENT AND ACCESSORIES I ESTABLISHED TO MONUMENT THE ORIGINAL LOCATION OF THIS CORNER:

At position of found iron pin, I set a 2 1/2" x 30" aluminum pipe, 29" in the ground, with 3" aluminum cap marked as shown below, from which:

NEW BEARING OBJECTS:

- A 5/8" x 30" iron pin bears North 28°10' East, a distance of 12.65 feet with 1 1/2" aluminum cap marked NE RP BGB SURVEY MARKER.
- A 5/8" x 30" iron pin bears South 58°52' East, a distance of 17.25 feet with 1 1/2" aluminum cap marked SE RP BGB SURVEY MARKER.
- A 5/8" x 30" iron pin bears South 40°27' West, a distance of 16.87 feet with 1 1/2" aluminum cap marked SW RP BGB SURVEY MARKER.
- A 5/8" x 30" iron pin bears North 61°07' West, a distance of 17.61 feet with 1 1/2" aluminum cap marked NW RP BGB SURVEY MARKER.

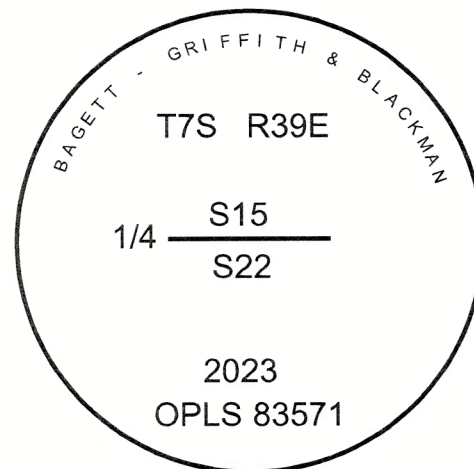

Buried stone on North edge

Set steel fence post approx. 1 foot South

I hereby certify that the corner was monumented on June 8, 2023.
Witness: Kyle Tucker



Renewal Date: June 30, 2025

I used a Leica GS18 with RTK in the establishment of the new accessories. Bearings and distances are measured to the center of the aluminum caps. Basis of bearing is as per survey for Brad Allen, filed concurrently.

N-15

FILED July 19, 2023
BAKER COUNTY SURVEYOR
SURVEY NO. 7-39-125