

CERTIFIED RECORD OF LAND CORNER MONUMENTATION


HISTORY OF ORIGINAL CORNER ESTABLISHED:

Corner originally established by David Thompson and Daniel Chaplin under GLO Contract Number 104, dated April 16th, 1864. Surveyor General Field Notes state:

Set post for cor. to secs. 14, 15, 22, + 23, in mound of earth with charred stake, pits, trench, as per instructions.

Foster road survey calls the center line of the road along the Section line.

T 7 S R 39 E N-17

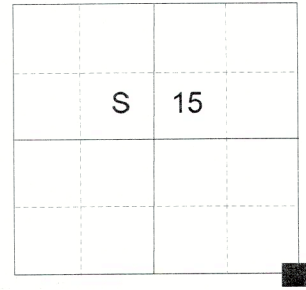

DESCRIPTION OF CORNER EVIDENCE FOUND:

None. Position falls along centerline of North/South bearing Haines Dump Road.

DESCRIPTION OF MONUMENT AND ACCESSORIES I ESTABLISHED TO MONUMENT THE ORIGINAL LOCATION OF THIS CORNER:

At position by Survey, I set a 5/8" x 30" iron pin, 33" in the ground, with 2 1/2" aluminum cap marked as shown below, from which:

NEW BEARING OBJECTS:


A 5/8" x 30" iron pin bears North 44°09' East, a distance of 23.52 feet with 1 1/2" aluminum cap marked NE RP BGB SURVEY MARKER.

A 5/8" x 30" iron pin bears South 49°59' East, a distance of 22.70 feet with 1 1/2" aluminum cap marked SE RP BGB SURVEY MARKER.

A 5/8" x 30" iron pin bears South 49°35' West, a distance of 18.07 feet with 1 1/2" aluminum cap marked SW RP BGB SURVEY MARKER.

A 5/8" x 30" iron pin bears North 35°32' West, a distance of 21.68 feet with 1 1/2" aluminum cap marked NW RP BGB SURVEY MARKER.

Set steel fence post approx. 0.5 feet East

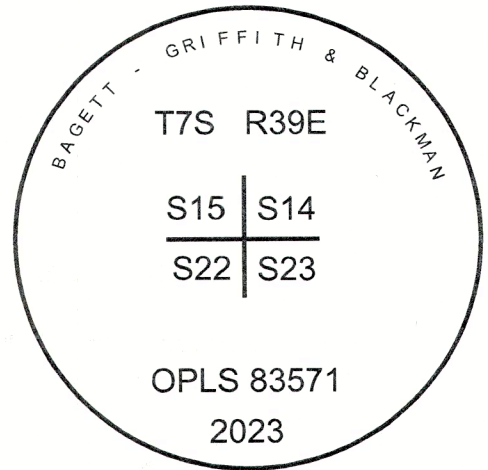

I hereby certify that the corner was monumented on June 2, 2023.
Witness: Kyle Tucker



Renewal Date: June 30, 2025

I used a Leica GS18 with RTK in the establishment of the new accessories. Bearings and distances are measured to the center of the aluminum caps. Basis of bearing is as per Survey filed concurrently.

N-17

FILED July 19, 2023
BAKER COUNTY SURVEYOR
SURVEY NO. 7-39-126